


WATER WELL PLUGGING RECORD Form WWC-5P KSA 82a-1212 ID NO.

Empty box for ID number

1 LOCATION OF WATER WELL: County: Wyandotte Fraction: NE 1/4 SW 1/4 NE 1/4 Section Number: 34 Township Number: 10S Range Number: 25 E

Distance and direction from nearest town or city street address of well if located within city? 2925 Fairfax Trafficway - Kansas City

2 WATER WELL OWNER: Huhtamaki Inc. RR#, St. Address, Box #: 9201 Packaging Dr. City, State, ZIP Code: De Soto, KS 66018 Global Positioning System (decimal degrees, min. of 4 digits) Latitude: Longitude: Elevation: Datum: Data Collection Method:

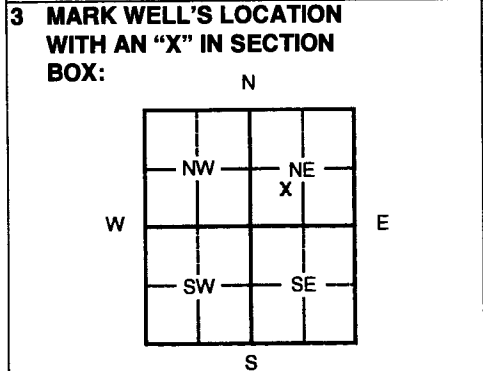

4 DEPTH OF WELL 55.75 ft. WELL'S STATIC WATER LEVEL 18.13 ft. WELL WAS USED AS: 1 Domestic, 2 Irrigation, 3 Feedlot, 4 Industrial, 5 Public Water Supply, 6 Oil Field Water Supply, 7 Domestic (Lawn & Garden), 8 Air Conditioning, 9 Dewatering, 10 Monitoring, 11 Injection Well, 12 Other. Was a chemical/bacteriological sample submitted to Department? Yes No X

5 TYPE OF BLANK CASING USED: 1 Steel, 2 PVC, 3 RMP (SR), 4 ABS, 5 Wrought, 6 Asbestos-Cement, 7 Fiberglass, 8 Concrete Tile, 9 Other (Specify below). Blank casing diameter 4 in. Was casing pulled? Yes X No. If yes, how much 3 ft. Casing height above or below land surface 36 in.

6 GROUT PLUG MATERIAL: 1 Neat cement, 2 Cement grout, 3 Bentonite, 4 Other. Grout Plug Intervals: From 1 ft. to 55.75 ft., From ft. to ft., From to ft. What is the nearest source of possible contamination: 1 Septic tank, 2 Sewer lines, 3 Watertight sewer lines, 4 Lateral lines, 5 Cess pool, 6 Seepage pit, 7 Pit privy, 8 Sewage lagoon, 9 Feedyard, 10 Livestock pens, 11 Fuel Storage, 12 Fertilizer storage, 13 Insecticide storage, 14 Abandoned water well, 15 Oil well/Gas well, 16 Other (specify below). Direction from well? How many feet?

Table with 6 columns: FROM, TO, PLUGGING MATERIALS, FROM, TO, PLUGGING MATERIALS. Row 1: 0, 1, Concrete. Row 2: 1, 55.75, Bentonite.

7 CONTRACTOR'S OR LANDOWNER'S CERTIFICATION: This water well was plugged under my jurisdiction and was completed on (mo/day/year) 04/17/12 and this record is true to the best of my knowledge and belief. Kansas Water Well Contractor's License No. 531. This Water Well Record was completed on (mo/day/year) 05/25/12 under the business name of Geotechnical Services, Inc. by (signature) Sarah Wato.

INSTRUCTIONS: Please fill in blanks or circle the correct answers. Send top three copies to Kansas Department of Health and Environment, Bureau of Water, Geology Section, 1000 SW Jackson St., Ste. 420, Topeka, Kansas 66612-1367. Telephone: 785/296-5522. Send one to Water Well Owner and retain one for your records. Visit us at http://www.kdheks.gov/waterwell.