


1 LOCATION OF WATER WELL:		Fraction	Section Number	Township Number	Range Number
County: Wyandotte		NE 1/4 SW 1/4 NE 1/4	27	T 10 S	R 25 E/W

Distance and direction from nearest town or city street address of well if located within city?
3201 Fairfax Trafficway, Kansas City

2 WATER WELL OWNER: **Kansas Dept of Health & Environ.**
 RR#, St. Address, Box # : **1000 SW Jackson St., Suite 410**
 City, State, ZIP Code : **Topeka, KS 66612**

Board of Agriculture, Division of Water Resources
 Application Number: _____

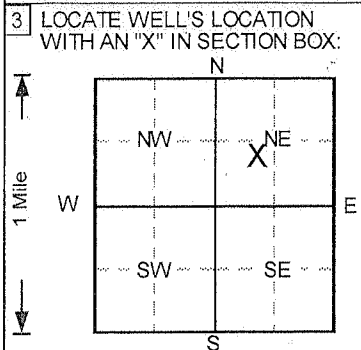

4 DEPTH OF COMPLETED WELL **59.5** ft. ELEVATION: _____

Depth(s) Groundwater Encountered 1. _____ ft. 2. _____ ft. 3. _____ ft.

WELL'S STATIC WATER LEVEL _____ ft. below land surface measured on mo/day/yr _____

Pump test data: Well water was **NA** ft. after _____ hours pumping _____ gpm
 Est. Yield **NA** gpm: Well water was _____ ft. after _____ hours pumping _____ gpm

Bore Hole Diameter **8** in. to **60** ft., and _____ in. to _____ ft.

WELL WATER TO BE USED AS:

5 Public water supply	8 Air conditioning	11 Injection well
1 Domestic	3 Feedlot	6 Oil field water supply
2 Irrigation	4 Industrial	7 Lawn and garden only
		10 Monitoring well

12 Other (Specify below) _____

Was a chemical/bacteriological sample submitted to Department? Yes _____ No **✓**; If yes, mo/day/yr sample was submitted _____

Water Well Disinfected? Yes _____ No **✓**

5 TYPE OF BLANK CASING USED:

1 Steel	3 RMP (SR)	5 Wrought iron	8 Concrete tile	CASING JOINTS: Glued _____ Clamped _____
2 PVC	4 ABS	6 Asbestos-Cement	9 Other (specify below) _____	Welded _____
		7 Fiberglass		Threaded ✓

Blank casing diameter **2** in. to **49** ft., Dia **2** in. to **59.5** ft., Dia _____ in. to _____ ft.

Casing height above land surface _____ in., weight _____ lbs./ft. Wall thickness or gauge No. _____

TYPE OF SCREEN OR PERFORATION MATERIAL

1 Steel	3 Stainless steel	5 Fiberglass	7 PVC	10 Asbestos-cement
2 Brass	4 Galvanized steel	6 Concrete tile	8 RMP (SR)	11 Other (specify) _____
		9 ABS		12 None used (open hole)

SCREEN OR PERFORATION OPENINGS ARE:

1 Continuous slot	3 Mill slot	5 Gauzed wrapped	8 Saw cut	11 None (open hole)
2 Louvered shutter	4 Key punched	6 Wire wrapped	9 Drilled holes	
		7 Torch cut	10 Other (specify) _____	

SCREEN-PERFORATED INTERVALS: From **49** ft. to **59** ft., From _____ ft. to _____ ft.
 From _____ ft. to _____ ft., From _____ ft. to _____ ft.

GRAVEL PACK INTERVALS: From **47** ft. to **60** ft., From _____ ft. to _____ ft.
 From _____ ft. to _____ ft., From _____ ft. to _____ ft.

6 GROUT MATERIAL:

1 Neat cement	2 Cement grout	3 Bentonite	4 Other Concrete
---------------	----------------	--------------------	-------------------------

Grout Intervals: From **0** ft. to **1** ft., From **1** ft. to **47** ft., From _____ ft. to _____ ft.

What is the nearest source of possible contamination:

1 Septic tank	4 Lateral lines	7 Pit privy	10 Livestock pens	14 Abandoned water well
2 Sewer lines	5 Cess pool	8 Sewage lagoon	11 Fuel storage	15 Oil well/Gas well
3 Watertight sewer lines	6 Seepage pit	9 Feedyard	12 Fertilizer storage	16 Other (specify below) _____
			13 Insecticide storage	

Direction from well? _____ How many feet? _____

FROM		TO		LITHOLOGIC LOG	FROM	TO	PLUGGING INTERVALS
0	2			Clay, some silt, Dark Grayish Brown			
2	14			Silt, Yellowish Brown			
14	15			Silt, some clay, Dark Gray			
15	40			Sand, fine, Yellowish Brown			
40	60			Sand, f-c, Brownish Gray			

7 CONTRACTOR'S OR LANDOWNER'S CERTIFICATION: This water well was **(1)** constructed, **(2)** reconstructed, or **(3)** plugged under my jurisdiction and was completed on (mo/day/year) **5/16/2013** and this record is true to the best of my knowledge and belief.

Kansas Water Well Contractor's License No. **527** This Water Well Record was completed on (mo/day/yr) **6/14/2013**

under the business name of **GeoCore, Inc.** by (signature) *[Signature]*

INSTRUCTIONS: Use typewriter or ball point pen. **PLEASE PRESS FIRMLY** and **PRINT** clearly. Please fill in blanks, underline or circle the correct answers. Send top three copies to Kansas Department of Health and Environment, Bureau of Water, Topeka, Kansas 66620-0001. Telephone: 913-296-5545. Send one to WATER WELL OWNER and retain one for your records.