


1 LOCATION OF WATER WELL: County: Wyandotte Fraction: NE 1/4 SW 1/4 NE 1/4 Section Number: 27 Township Number: T 10 S Range Number: R 25 E/W

Distance and direction from nearest town or city street address of well if located within city?

3201 Fairfax Trafficway, Kansas City

2 WATER WELL OWNER: Kansas Dept of Health & Environ. RR#, St. Address, Box #: 1000 SW Jackson St., Suite 410 City, State, ZIP Code: Topeka, KS 66612 Board of Agriculture, Division of Water Resources Application Number:

3 LOCATE WELL'S LOCATION WITH AN "X" IN SECTION BOX:

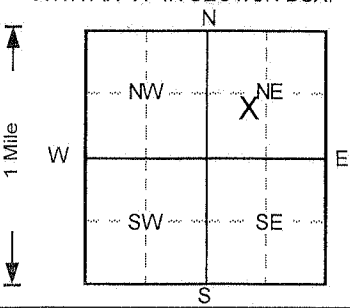

4 DEPTH OF COMPLETED WELL: 90.33 ft. ELEVATION: Depth(s) Groundwater Encountered: 1. ft. 2. ft. 3. ft. WELL'S STATIC WATER LEVEL: below land surface measured on mo/day/yr Pump test data: Well water was NA ft. after ... hours pumping ... gpm Est. Yield: NA gpm: Well water was ... ft. after ... hours pumping ... gpm Bore Hole Diameter: 8 in. to 90 ft. and ... in. to ... ft. WELL WATER TO BE USED AS: 5 Public water supply 8 Air conditioning 11 Injection well 1 Domestic 3 Feedlot 6 Oil field water supply 9 Dewatering 12 Other (Specify below) 2 Irrigation 4 Industrial 7 Lawn and garden only 10 Monitoring well Was a chemical/bacteriological sample submitted to Department? Yes No; If yes, mo/day/yr sample was submitted Water Well Disinfected? Yes No

5 TYPE OF BLANK CASING USED: 1 Steel 2 PVC 3 RMP (SR) 4 ABS 5 Wrought iron 6 Asbestos-Cement 7 Fiberglass 8 Concrete tile 9 Other (specify below) CASING JOINTS: Glued Clamped Welded Threaded Casing diameter: 2 in. to 80 ft. Dia: 2 in. to 90.33 ft. Dia: in. to ... ft. Casing height above land surface: 31 in., weight: lbs./ft. Wall thickness or gauge No: Sch. 40 TYPE OF SCREEN OR PERFORATION MATERIAL: 1 Steel 2 Brass 3 Stainless steel 4 Galvanized steel 5 Fiberglass 6 Concrete tile 7 PVC 8 RMP (SR) 9 ABS 10 Asbestos-cement 11 Other (specify) 12 None used (open hole) SCREEN OR PERFORATION OPENINGS ARE: 1 Continuous slot 2 Louvered shutter 3 Mill slot 4 Key punched 5 Gauzed wrapped 6 Wire wrapped 7 Torch cut 8 Saw cut 9 Drilled holes 10 Other (specify) 11 None (open hole) SCREEN-PERFORATED INTERVALS: From 80 ft. to 90 ft. From ... ft. to ... ft. GRAVEL PACK INTERVALS: From 78 ft. to 90 ft. From ... ft. to ... ft.

6 GROUT MATERIAL: 1 Neat cement 2 Cement grout 3 Bentonite 4 Other Concrete Grout Intervals: From 0 ft. to 2.5 ft. From 2.5 ft. to 78 ft. From ... ft. to ... ft. What is the nearest source of possible contamination: 1 Septic tank 2 Sewer lines 3 Watertight sewer lines 4 Lateral lines 5 Cess pool 6 Seepage pit 7 Pit privy 8 Sewage lagoon 9 Feedyard 10 Livestock pens 11 Fuel storage 12 Fertilizer storage 13 Insecticide storage 14 Abandoned water well 15 Oil well/Gas well 16 Other (specify below) Direction from well? How many feet?

Table with 2 columns: LITHOLOGIC LOG (FROM, TO) and PLUGGING INTERVALS. Rows include: 0-2 Clay, some silt, Dark Grayish Brown; 2-14 Silt, Yellowish Brown; 14-15 Silt, some clay, Dark Gray; 15-40 Sand, fine, Yellowish Brown; 40-90 Sand, f-c, Brownish Gray. Includes entry: TMW-146-C, Abovegrade

7 CONTRACTOR'S OR LANDOWNER'S CERTIFICATION: This water well was (1) constructed, (2) reconstructed, or (3) plugged under my jurisdiction and was completed on (mo/day/year) 5/16/2013 and this record is true to the best of my knowledge and belief. Kansas Water Well Contractor's License No. 527. This Water Well Record was completed on (mo/day/yr) 6/14/2013 under the business name of GeoCore, Inc. by (signature)

OFFICE USE ONLY T R EW SEC 1/4 1/4