


1 LOCATION OF WATER WELL: County: Wyandotte Fraction NW 1/4 SW 1/4 NE 1/4 Section Number 27 Township Number T 10 S Range Number R 25 E/W

Distance and direction from nearest town or city street address of well if located within city? 3201 Fairfax Trafficway, Kansas City

2 WATER WELL OWNER: Kansas Dept of Health & Environ. RR#, St. Address, Box #: 1000 SW Jackson St., Suite 410 City, State, ZIP Code: Topeka, KS 66612 Board of Agriculture, Division of Water Resources Application Number:

3 LOCATE WELL'S LOCATION WITH AN "X" IN SECTION BOX:

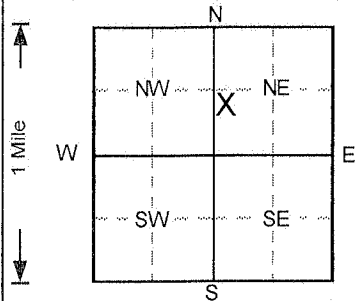

4 DEPTH OF COMPLETED WELL 90.45 ft. ELEVATION: ... WELL'S STATIC WATER LEVEL ... Pump test data: Well water was NA ft. after ... Est. Yield NA gpm: Well water was ... Bore Hole Diameter 8 in. to 90 ft. and ... WELL WATER TO BE USED AS: 10 Monitoring well ... Was a chemical/bacteriological sample submitted? No ... Water Well Disinfected? No

5 TYPE OF BLANK CASING USED: 2 PVC Blank casing diameter 2 in. to 80 ft. Dia 2 in. to 90.45 ft. Dia ... TYPE OF SCREEN OR PERFORATION MATERIAL: 7 PVC ... SCREEN OR PERFORATION OPENINGS ARE: 3 Mill slot ... SCREEN-PERFORATED INTERVALS: From 80 ft. to 90 ft. ... GRAVEL PACK INTERVALS: From 78 ft. to 90 ft.

6 GROUT MATERIAL: 4 Other Concrete Grout Intervals: From 0 ft. to 3 ft. From 3 ft. to 78 ft. What is the nearest source of possible contamination: 10 Livestock pens 14 Abandoned water well ... Direction from well?

Table with columns: FROM, TO, LITHOLOGIC LOG, FROM, TO, PLUGGING INTERVALS. Rows: 0-3 Clay, silty, Dark Brown; 3-10 Silt, Brown; 10-14 Clay w/silt, Brown; 14-16 Sand, vf.; 16-18 Clay, Gray; 18-75 No cuttings; 75-90 Gravel and clay w/wthrd. shale.

7 CONTRACTOR'S OR LANDOWNER'S CERTIFICATION: This water well was (1) constructed, (2) reconstructed, or (3) plugged under my jurisdiction and was completed on (mo/day/year) 5/16/2013 and this record is true to the best of my knowledge and belief. Kansas Water Well Contractor's License No. 527. This Water Well Record was completed on (mo/day/yr) 6/14/2013 under the business name of GeoCore, Inc. by (signature) Dan Bell

INSTRUCTIONS: Use typewriter or ball point pen. PLEASE PRESS FIRMLY and PRINT clearly. Please fill in blanks, underline or circle the correct answers. Send top three copies to Kansas Department of Health and Environment, Bureau of Water, Topeka, Kansas 66620-0001. Telephone: 913-296-5545. Send one to WATER WELL OWNER and retain one for your records.

OFFICE USE ONLY

T

R

EMW

SEC.

1/4

1/4

1/4