

County: Wyandotte Fraction SE SW SW NE Sec. 27 T 10 S R 25 EDW

CORRECTION(S) TO WATER WELL COMPLETION RECORD (WWC-5)
(to rectify lacking or incorrect information)

Owner: Racer Trust

Location was listed as:

Section-Township-Range: None Given

Fraction (1/4 1/4 1/4): _____

Location changed to:

27-10S-25E

SE SW SW NE

Other changes: Initial statements: _____

Changed to: _____

Comments: _____

Verification method: Latitude & Longitude, KGS' "LEO" conversion tool,
well site address & area road map, and mapping tool on
KGS website initials: ORA date: 1/7/2014


Submitted by: Kansas Geological Survey, Data Resources Library, 1930 Constant Ave., Lawrence, KS 66047-3726
to: Kansas Dept of Health & Environment, Bureau of Water, 1000 SW Jackson, Suite 420, Topeka, KS 66612-1367.

1 LOCATION OF WATER WELL: Fraction $\frac{1}{4}$ $\frac{1}{4}$ $\frac{1}{4}$ $\frac{1}{4}$ Section Number Township Number Range Number
 County: Wyandotte T S E W

Street/Rural Address of Well Location; if unknown, distance & direction from nearest town or intersection: If at owner's address, check here
401 Kindleberger Road, KCKS 66115
R near Trust

2 WATER WELL OWNER: Mr. Robert + Huro
 RR#, St. Address, Box #: 2930 Ecorse Road
 City, State ZIP Code: YPSILANTI, MI 48198

Global Positioning Systems (GPS) information:
 Latitude: 39.150427 (in decimal degrees)
 Longitude: -94.611048 (in decimal degrees)
 Elevation: _____
 Datum: WGS84, NAD83, NAD27
 Collection Method: _____
 GPS unit (Make/Model: _____)
 Digital Map/Photo, Topographic Map, Land Survey
 Est. Accuracy: <3 m, 3-5 m, 5-15 m, >15 m

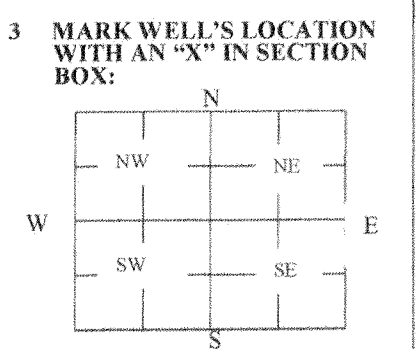

4 DEPTH OF WELL 58.5 ft. Monitoring well MW-118B
 WELL'S STATIC WATER LEVEL _____ ft
 WELL WAS USED AS:
 Domestic Public Water Supply Dewatering
 Irrigation Oil Field Water Supply Monitoring
 Feedlot Domestic (Lawn & Garden) Injection Well
 Industrial Air Conditioning Other _____
 Was a chemical/bacteriological sample submitted to Department? Yes No

5 TYPE OF BLANK CASING USED:
 Steel RMP (SR) Wrought Fiberglass Other (Specify below)
 PVC ABS Asbestos-Cement Concrete Tile
 Blank casing diameter 2 in. Was casing pulled? Yes No If yes, how much top 5 note! entire
 Casing height above or below land surface _____ in. will fill in, then top five feet + drilled then back filled.

6 GROUT PLUG MATERIAL: Neat cement Cement grout Bentonite Other _____
 Grout Plug Intervals: From 0 ft. to 58.5 ft., From _____ ft. to _____ ft., From _____ ft. to _____ ft.

What is the nearest source of possible contamination:
 Septic tank Seepage pit Fuel storage Other (specify below)
 Sewer lines Pit privy Fertilizer storage
 Watertight sewer lines Sewage lagoon Insecticide storage
 Lateral lines Feedyard Abandoned water well Direction from well? _____
 Cess pool Livestock pens Oil well/Gas well How many feet? _____

FROM	TO	PLUGGING MATERIALS	FROM	TO	PLUGGING MATERIALS
<u>0</u>	<u>58.5</u>	<u>Bentonite</u>			

7 CONTRACTOR'S OR LANDOWNER'S CERTIFICATION: This water well was plugged under my jurisdiction and was completed on (mo/day/year) 11/27/13 and this record is true to the best of my knowledge and belief. Kansas Water Well Contractor's License No. 650. This Water Well Record was completed on (mo/day/year) 12/11/13 under the business name of K&E P&C I by (signature) [Signature]

INSTRUCTIONS: Use typewriter or ballpoint pen. Please press firmly and print clearly. Please fill in blanks, underline or circle the correct answers. Send top three copies to Kansas Department of Health and Environment, Bureau of Water, Geology Section, 1000 SW Jackson St., Ste. 420, Topeka, Kansas 66612-1367. Telephone: 785/296-5524. Send one to Water Well Owner and retain one for your records. Visit us at <http://www.kdheks.gov/waterwell/index.html>.



STRATIGRAPHIC AND INSTRUMENTATION LOG (OVERBURDEN)

PROJECT NAME: FAIRFAX I PLANT SITE

HOLE DESIGNATION: MW-118B

PROJECT NUMBER: 12559

DATE COMPLETED: December 13, 2005

CLIENT: GM

DRILLING METHOD: 4 1/4 ID HSA

LOCATION: KANSAS CITY, KANSAS

FIELD PERSONNEL: S.COBB

DRILLING CONTRACTOR: HARRISS DRILLING SERVICES

DRILLER: C.D.

DEPTH ft BGS	STRATIGRAPHIC DESCRIPTION & REMARKS	ELEV. ft AMSL	MONITOR WELL	SAMPLE				
				NUMBER	INTERVAL	REC (ft)	IN VALUE	
	TOP OF CASING GROUND SURFACE	746.86 744.00	<p style="font-size: small;">CONCRETE</p> <p style="font-size: small;">CEMENT/ BENTONITE GROUT</p> <p style="font-size: small;">2" Ø WELL CASING</p> <p style="font-size: small;">8" Ø BOREHOLE</p> <p style="font-size: small;">BENTONITE CHIPS</p> <p style="font-size: small;">SAND PACK</p> <p style="font-size: small;">2" Ø WELL SCREEN</p>					
5	No Sample Collected							
10								
15								
20								
25								
30								
35								
40								
45								
50								
55								
60	END OF BOREHOLE @ 60.0ft BGS	684.00	<p style="font-size: small;">WELL DETAILS</p> <p style="font-size: x-small;">Screened interval: 695.50 to 685.50ft AMSL 48.50 to 58.50ft BGS</p> <p style="font-size: x-small;">Length: 10ft Diameter: 2in Slot Size: 10 Material: PVC Sand Pack: 697.50 to 684.00ft AMSL 46.50 to 60.00ft BGS Material: SAND #5</p>					
65								
70								
75								

OVERBURDEN LOG - 12559-50 MW/DEC 05 SAMPLING GP J CRA CORP GDT 5/6/06

NOTES: MEASURING POINT ELEVATIONS MAY CHANGE; REFER TO CURRENT ELEVATION TABLE