

WATER WELL RECORD Form WWC-5


Division of Water Resources App. No. []

Well ID []

Original Record Correction Change in Well Use

1 LOCATION OF WATER WELL: County: Wyandotte Fraction 1/4 1/4 SE 1/4 NE 1/4 Section Number 29 Township Number T 10 S Range Number R 25 E W

2 WELL OWNER: Last Name: Business: Maellan Midstream Partners, L.P. Address: One Williams Center City: Tulsa State: OK ZIP: 74172 Street or Rural Address where well is located (if unknown, distance and direction from nearest town or intersection): If at owner's address, check here: North of 12th Street & Esplande on N. side of RR tracks

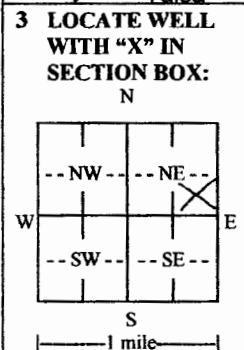

4 DEPTH OF COMPLETED WELL: 40 ft. Depth(s) Groundwater Encountered: 1) NA ft. 2) ft. 3) ft. or 4) Dry Well WELL'S STATIC WATER LEVEL: ft. below land surface, measured on (mo-day-yr) above land surface, measured on (mo-day-yr) Pump test data: Well water was ft. after hours pumping gpm Well water was ft. after hours pumping gpm Estimated Yield: gpm Bore Hole Diameter: 3.25 in. to 40 ft and in. to ft.

5 Latitude: 39.148720 (decimal degrees) **Longitude:** -94.640515 (decimal degrees) **Horizontal Datum:** WGS 84 NAD 83 NAD 27 **Source for Latitude/Longitude:** GPS (unit make/model:) (WAAS enabled? Yes No) Land Survey Topographic Map Online Mapper: Google earth **6 Elevation:** ft. Ground Level TOC **Source:** Land Survey GPS Topographic Map Other

7 WELL WATER TO BE USED AS:

- 1. Domestic: Household Lawn & Garden Livestock
- 2. Irrigation
- 3. Feedlot
- 4. Industrial
- 5. Public Water Supply: well ID
- 6. Dewatering: how many wells?
- 7. Aquifer Recharge: well ID
- 8. Monitoring: well ID
- 9. Environmental Remediation: well ID INJ-7 Air Sparge Soil Vapor Extraction Recovery Injection
- 10. Oil Field Water Supply: lease
- 11. Test Hole: well ID Cased Uncased Geotechnical
- 12. Geothermal: how many bores? a) Closed Loop Horizontal Vertical b) Open Loop Surface Discharge Inj. of Water
- 13. Other (specify):

Was a chemical/bacteriological sample submitted to KDHE? Yes No If yes, date sample was submitted: Water well disinfected? Yes No

8 TYPE OF CASING USED: Steel PVC Other CASING JOINTS: Glued Clamped Welded Threaded Casing diameter 1 in. to 38 ft, Diameter in. to ft, Diameter in. to ft. Casing height above land surface 0 in. Weight lbs./ft. Wall thickness or gauge No. sch 40 **TYPE OF SCREEN OR PERFORATION MATERIAL:** Steel Stainless Steel Fiberglass PVC Other (Specify) Brass Galvanized Steel Concrete tile None used (open hole) **SCREEN OR PERFORATION OPENINGS ARE:** Continuous Slot Mill Slot Gauze Wrapped Torch Cut Drilled Holes Other (Specify) Louvered Shutter Key Punched Wire Wrapped Saw Cut None (Open Hole) **SCREEN-PERFORATED INTERVALS:** From 38 ft to 40 ft, From ft to ft, From ft to ft. **GRAVEL PACK INTERVALS:** From 36 ft to 40 ft, From ft to ft, From ft to ft.

9 GROUT MATERIAL: Neat cement Cement grout Bentonite Other Neat intervals: From 0 ft to 36 ft, From ft to ft, From ft to ft. **Nearest source of possible contamination:** Septic Tank Lateral Lines Pit Privy Livestock Pens Insecticide Storage Sewer Lines Cess Pool Sewage Lagoon Fuel Storage Abandoned Water Well Watertight Sewer Lines Seepage Pit Feedyard Fertilizer Storage Oil Well/Gas Well Other (Specify) Direction from well? Distance from well? ft.

10 FROM	TO	LITHOLOGIC LOG	FROM	TO	LITHO. LOG (cont.) or PLUGGING INTERVALS
		NA			

11 CONTRACTOR'S OR LANDOWNER'S CERTIFICATION: This water well was constructed, reconstructed, or plugged under my jurisdiction and was completed on (mo-day-year) 2-20-16 and this record is true to the best of my knowledge and belief. Kansas Water Well Contractor's License No. 604 This Water Well Record was completed on (mo-day-year) 6-15-16 under the business name of Environmental Priority Service, Inc. Signature []

Mail 1 white copy along with a fee of \$5.00 for each constructed well to: Kansas Department of Health and Environment, Bureau of Water, GWTS Section, 1000 SW Jackson St., Suite 420, Topeka, Kansas 66612-1367. Mail one to Water Well Owner and retain one for your records. Telephone 785-296-5524. Visit us at <http://www.kdheks.gov/waterwell/index.html> KSA 82a-1212 Revised 7/10/2015