

**WATER WELL RECORD Form WWC-5**

Original Record  Correction  Change in Well Use

Division of Water Resources App. No.

Well ID **MW09R**

**1 LOCATION OF WATER WELL:** Fraction  $\frac{1}{4}$  NW  $\frac{1}{4}$  SW  $\frac{1}{4}$  SW  $\frac{1}{4}$  Section Number **27** Township Number T **10** S Range Number R **25**  E  W  
County: **Wyandotte**

**2 WELL OWNER:** Last Name **Cibrik** First **Jerome** Street or Rural Address where well is located (if unknown, distance and direction from nearest town or intersection): If at owner's address, check here:   
Business **Union Carbide Corporation** **3126 Brinkerhoff Road**  
Address **PO Box 8361**  
Address **2001 Union Carbide Drive**  
City: **South Charleston** State: **WV** ZIP: **25303** **Kansas City, K.S. 66115**

**3 LOCATE WELL WITH "X" IN SECTION BOX:**  
N  

-- NW --			-- NE --
-- SW --			-- SE --

  
W E  
S  
1 mile

**4 DEPTH OF COMPLETED WELL:** **50** ft.  
Depth(s) Groundwater Encountered: 1) **15** ft.  
2) ..... ft. 3) ..... ft., or 4)  Dry Well  
WELL'S STATIC WATER LEVEL: ..... ft.  
 below land surface, measured on (mo-day-yr).....  
 above land surface, measured on (mo-day-yr).....  
Pump test data: Well water was ..... ft.  
after..... hours pumping ..... gpm  
Well water was ..... ft.  
after..... hours pumping ..... gpm  
Estimated Yield: ..... gpm  
Bore Hole Diameter: **10** in. to **2** ft. and  
**6** in. to **50** ft.

**5 Latitude:** **39.145308** ..... (decimal degrees)  
**Longitude:** **-94.621123** ..... (decimal degrees)  
Horizontal Datum:  WGS 84  NAD 83  NAD 27  
Source for Latitude/Longitude:  
 GPS (unit make/model: .....)  
(WAAS enabled?  Yes  No)  
 Land Survey  Topographic Map  
 Online Mapper: .....

**6 Elevation:** **745** ft.  Ground Level  TOC  
Source:  Land Survey  GPS  Topographic Map  
 Other **PIAC SITE SURVEY**

**7 WELL WATER TO BE USED AS:**  
1. Domestic:  Household  Lawn & Garden  Livestock  Irrigation  Feedlot  Industrial  
2.  Public Water Supply: well ID .....  
3.  Dewatering: how many wells? .....  
4.  Aquifer Recharge: well ID .....  
5.  Monitoring: well ID **MW-09R**  
6.  Air Sparge  Soil Vapor Extraction  Recovery  Injection  
7.  Oil Field Water Supply: lease .....  
8.  Test Hole: well ID .....  
9.  Cased  Uncased  Geotechnical  
10.  Geothermal: how many bores? .....  
11. a) Closed Loop  Horizontal  Vertical  
b) Open Loop  Surface Discharge  Inj. of Water  
12.  Other (specify): .....

Was a chemical/bacteriological sample submitted to KDHE?  Yes  No If yes, date sample was submitted: .....  
Water well disinfected?  Yes  No

**8 TYPE OF CASING USED:**  Steel  PVC  Other ..... CASING JOINTS:  Glued  Clamped  Welded  Threaded  
Casing diameter **2** in. to **40** ft., Diameter ..... in. to ..... ft., Diameter ..... in. to ..... ft.  
Casing height above land surface **0** in. Weight **1.70** lbs./ft. Wall thickness or gauge No. **SA-40**  
TYPE OF SCREEN OR PERFORATION MATERIAL:  
 Steel  Stainless Steel  Fiberglass  PVC  Other (Specify) .....  
 Brass  Galvanized Steel  Concrete tile  None used (open hole)  
SCREEN OR PERFORATION OPENINGS ARE:  
 Continuous Slot  Mill Slot  Gauze Wrapped  Torch Cut  Drilled Holes  Other (Specify) .....  
 Louvered Shutter  Key Punched  Wire Wrapped  Saw Cut  None (Open Hole)  
SCREEN-PERFORATED INTERVALS: From **40** ft. to **50** ft., From ..... ft. to ..... ft., From ..... ft. to ..... ft.  
GRAVEL PACK INTERVALS: From **38** ft. to **50** ft., From ..... ft. to ..... ft., From ..... ft. to ..... ft.

**9 GROUT MATERIAL:**  Neat cement  Cement grout  Bentonite  Other .....  
Grout Intervals: From **36** ft. to **2** ft., From ..... ft. to ..... ft., From ..... ft. to ..... ft.  
Nearest source of possible contamination:  
 Septic Tank  Lateral Lines  Pit Privy  Livestock Pens  Insecticide Storage  
 Sewer Lines  Cess Pool  Sewage Lagoon  Fuel Storage  Abandoned Water Well  
 Watertight Sewer Lines  Seepage Pit  Feedyard  Fertilizer Storage  Oil Well/Gas Well  
 Other (Specify) .....


Direction from well? ..... Distance from well? ..... ft.

10 FROM	TO	LITHOLOGIC LOG	FROM	TO	LITHO. LOG (cont.) or PLUGGING INTERVALS
<b>0</b>	<b>1</b>	<b>overburden</b>			
<b>1</b>	<b>15</b>	<b>clay/silt</b>			
<b>15</b>	<b>50</b>	<b>sand w/ silt and clay seams</b>			


Notes:

**11 CONTRACTOR'S OR LANDOWNER'S CERTIFICATION:** This water well was  constructed,  reconstructed, or  plugged under my jurisdiction and was completed on (mo-day-yr) **8-22-2016** and this record is true to the best of my knowledge and belief. Kansas Water Well Contractor's License No. **597** This Water Well Record was completed on (mo-day-yr) **8-22-2016** under the business name of **Saracade Drilling** Signature *[Signature]*

UNISON BUILDING MONITORING WELL LOCATIONS AND LIMITS

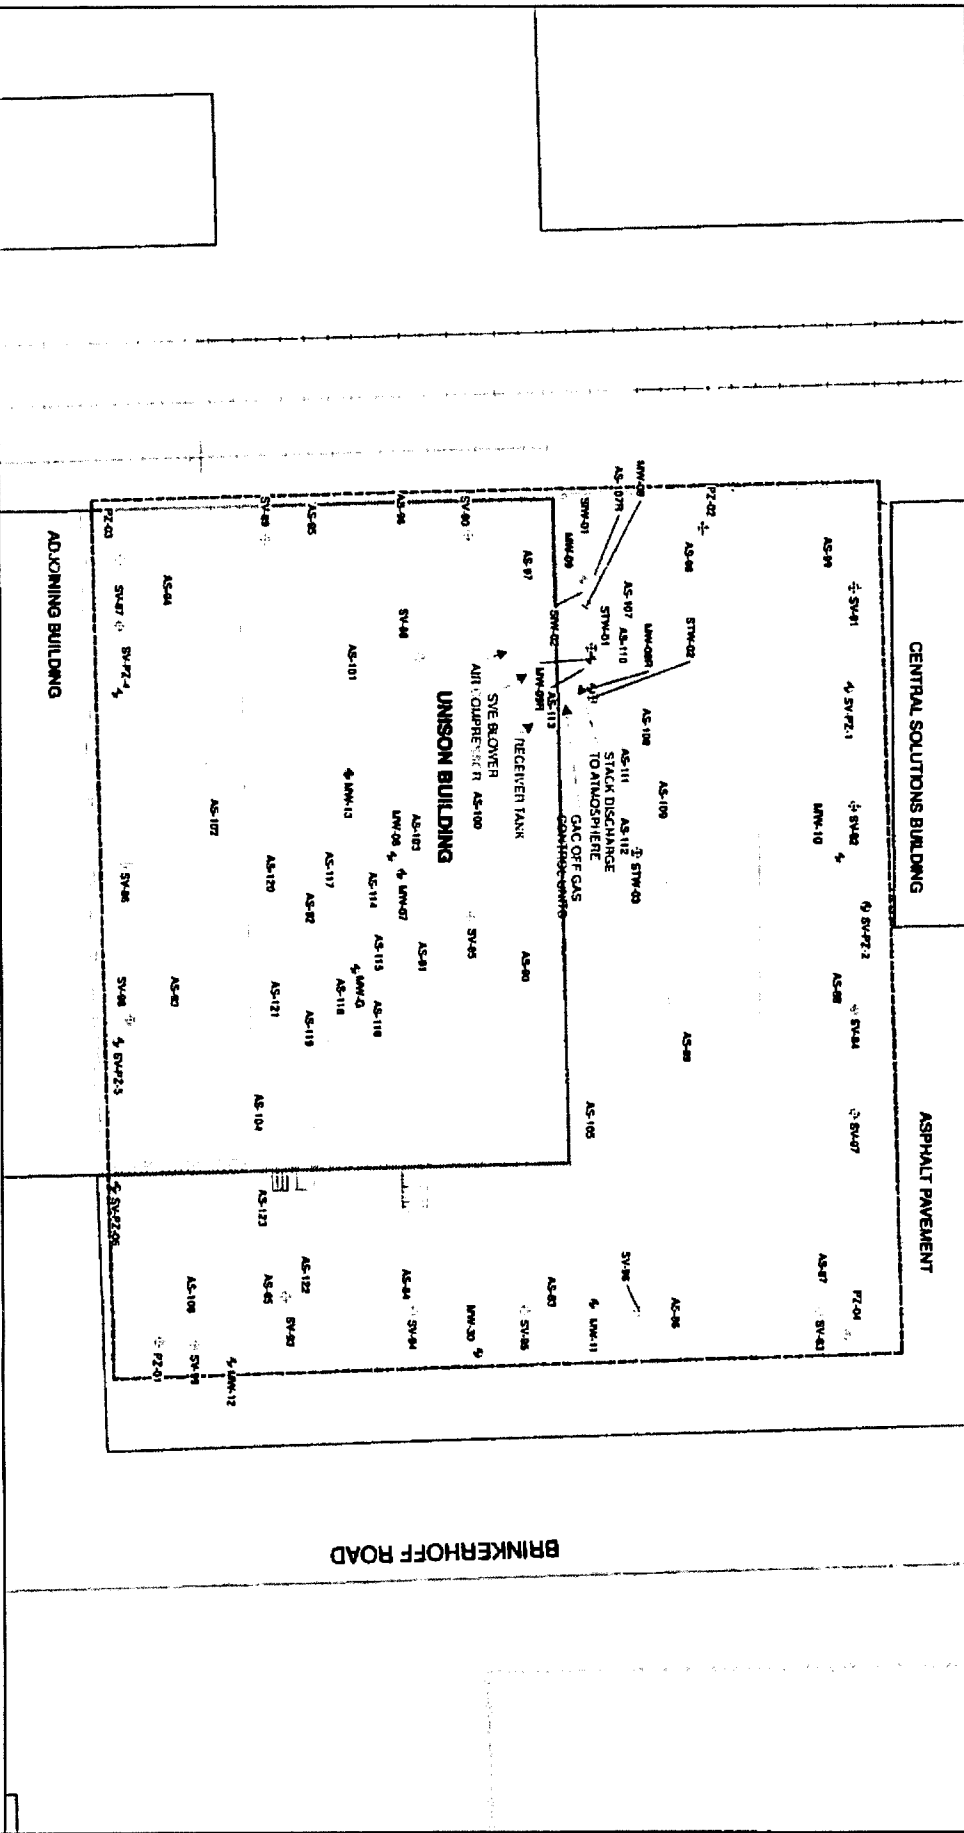

- Legend**
- Abandoned Monitoring Well Location
  - Air Sparge Well Location
  - Monitoring Well Location
  - Piezometer
  - Spill/Leak Test Well
  - SVE Well Locations
  - SVE Piezometer
  - Site Limits
  - Fence

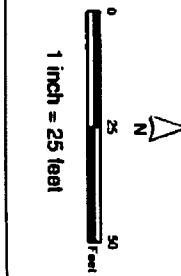

2016 Onsite Monitoring Wells  
Former Unison Transformer Services, Inc. Site

**CH2M**