


1 LOCATION OF WATER WELL: Fraction 1/4 NW 1/4 SW 1/4 SW 1/4 Section Number 27 Township Number T 10 S Range Number 25 E W
 County: Wyandotte

Street/Rural Address of Well Location: if unknown, distance & direction from nearest town or intersection: If at owner's address, check here 3126 Brikerhoff Road Kansas City, KS. 66115
 Global Positioning Systems (GPS) information:
 Latitude: 39.145308 (in decimal degrees)
 Longitude: -94.621123 (in decimal degrees)
 Elevation: 745
 Horizontal Datum: WGS84, NAD83, NAD27
 Collection Method:

2 WATER WELL OWNER: Union Carbide Corporation
 RR#, St. Address, Box #: PO Box 8361
2001 Union Carbide Drive
 City, State ZIP Code: South Charleston, WV, 25303
 Est. Accuracy: < 3 m. 3-5 m. 5-15 m. > 15 m

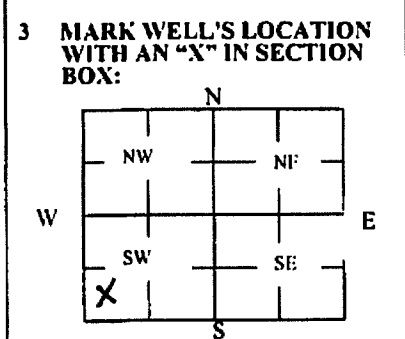

4 DEPTH OF WELL 50 ft.
 WELL'S STATIC WATER LEVEL 15 ft.
 WELL WAS USED AS:
 Domestic Public Water Supply Dewatering
 Irrigation Oil Field Water Supply Monitoring
 Feedlot Domestic (Lawn & Garden) Injection Well
 Industrial Air Conditioning
 Was a chemical/bacteriological sample submitted to Department? Yes No


5 TYPE OF BLANK CASING USED:
 Steel RMP (SR) Wrought Fiberglass Other (Specify below)
 PVC ABS Asbestos-Cement Concrete Tile
 Blank casing diameter 2 in. Was casing pulled? Yes No If yes, how much 40'
 Casing height above or below land surface _____ in.

6 GROUT PLUG MATERIAL: Neat cement Cement grout Bentonite Other _____
 Grout Plug Intervals: From 0 ft. to 50 ft., From _____ ft. to _____ ft., From _____ ft. to _____ ft.
 What is the nearest source of possible contamination:
 Septic tank Seepage pit Fuel storage Other (specify below)
 Sewer lines Pit privy Fertilizer storage
 Watertight sewer lines Sewage lagoon Insecticide storage
 Lateral lines Feedyard Abandoned water well Direction from well? _____
 Cess pool Livestock pens Oil well/Gas well How many feet? _____

FROM	TO	PLUGGING MATERIALS	FROM	TO	PLUGGING MATERIALS
<u>0</u>	<u>50'</u>	<u>High Solids Sodium Bentonite Grout Slurry</u>			

7 CONTRACTOR'S OR LANDOWNER'S CERTIFICATION: This water well was plugged under my jurisdiction and was completed on (mo/day/year) 8-23-2016 and this record is true to the best of my knowledge and belief. Kansas Water Well Contractor's License No. 597. This Water Well Record was completed on (mo/day/year) 8-23-2016 under the business name of Cascade Drilling by (signature) [Signature]

Send one white copy to Kansas Department of Health & Environment, Geology Section, 1000 SW Jackson Street, Ste. 420, Topeka, KS 66612-1367. Send one copy to WATER WELL OWNER and retain one for your records.
 Visit us at <http://www.kdheks.gov/waterwell/index.html> Telephone 785-296-5524.

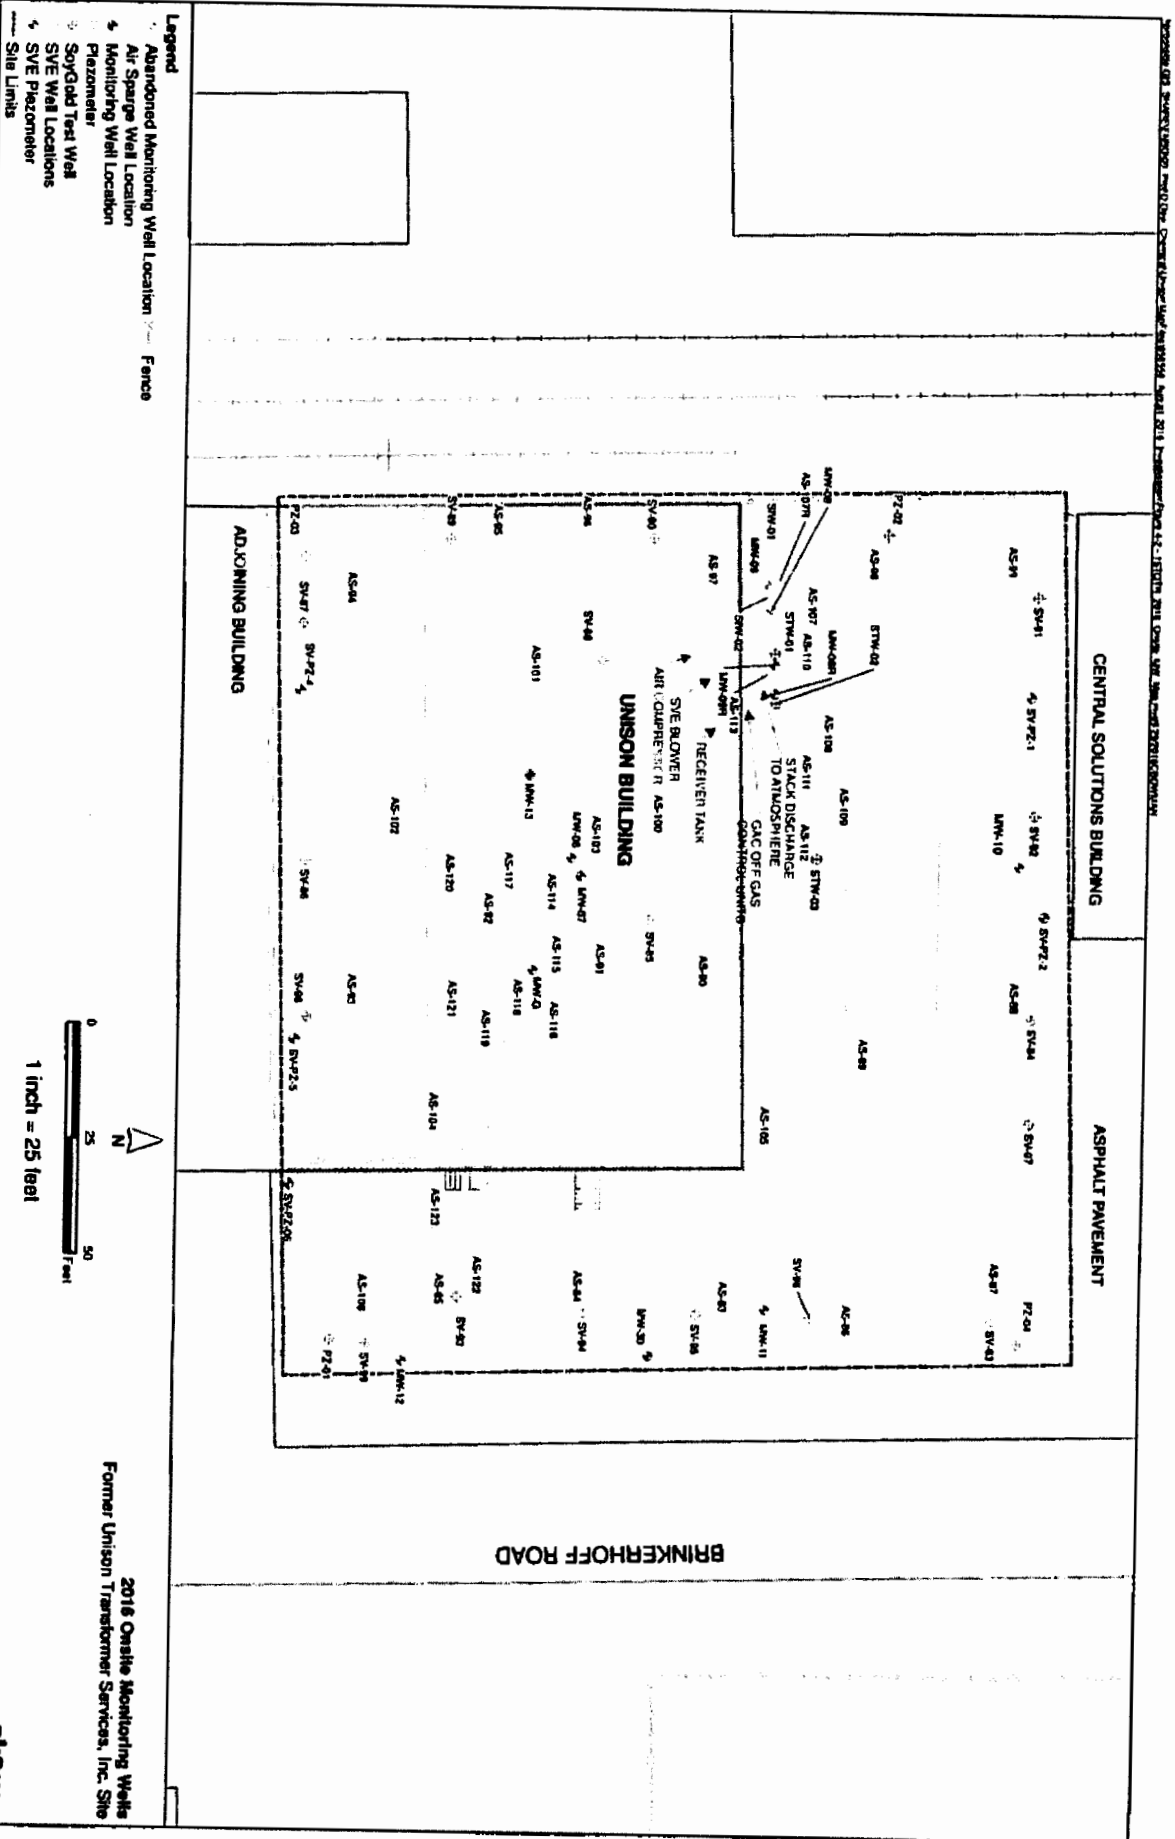

2016 Onsite Monitoring Wells
Former Unison Transformer Services, Inc. Site

