

**WATER WELL RECORD Form WWC-5**


Division of Water Resources App. No.

Well ID

Original Record  Correction  Change in Well Use

<b>1 LOCATION OF WATER WELL:</b> County: Wyandotte	Fraction ¼ SE ¼ SE ¼ NE ¼	Section Number 29	Township Number T 10 S	Range Number R 25 <input checked="" type="checkbox"/> E <input type="checkbox"/> W
---	------------------------------	----------------------	---------------------------	---

<b>2 WELL OWNER:</b> Last Name: First: Business: <b>Maellan Midstream Partners, LLP</b> Address: <b>PO Box 22186</b> Address: City: <b>Tulsa</b> State: <b>OK</b> ZIP: <b>74121</b>	Street or Rural Address where well is located (if unknown, distance and direction from nearest town or intersection): If at owner's address, check here: <input type="checkbox"/> <b>3601 North 12th Street Kansas City, KS 66104</b>
---	--

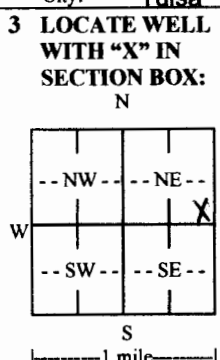

**4 DEPTH OF COMPLETED WELL:** ..... 40 ..... ft.  
Depth(s) Groundwater Encountered: 1) ..... 20 ..... ft.  
2) ..... N/A ..... ft. 3) ..... N/A ..... ft., or 4)  Dry Well  
WELL'S STATIC WATER LEVEL: ..... ft.  
 below land surface, measured on (mo-day-yr) ..... 6-9-2016  
 above land surface, measured on (mo-day-yr) .....  
Pump test data: Well water was ..... N/A ..... ft.  
after ..... N/A ..... hours pumping ..... N/A ..... gpm  
Well water was ..... N/A ..... ft.  
after ..... N/A ..... hours pumping ..... N/A ..... gpm  
Estimated Yield: ..... N/A ..... gpm  
Bore Hole Diameter: ..... 3.25 ..... in. to ..... 40 ..... ft. and  
..... N/A ..... in. to ..... N/A ..... ft.

**5 Latitude:** ..... 39.149164 ..... (decimal degrees)  
**Longitude:** ..... -94.640906 ..... (decimal degrees)  
**Horizontal Datum:**  WGS 84  NAD 83  NAD 27  
**Source for Latitude/Longitude:**  
 GPS (unit make/model: .....)  
(WAAS enabled?  Yes  No)  
 Land Survey  Topographic Map  
 Online Mapper: **Google Earth**

**6 Elevation:** 761 ..... ft.  Ground Level  TOC  
**Source:**  Land Survey  GPS  Topographic Map  
 Other **Google Earth**

**7 WELL WATER TO BE USED AS:**

1. Domestic: <input type="checkbox"/> Household <input type="checkbox"/> Lawn & Garden <input type="checkbox"/> Livestock	5. <input type="checkbox"/> Public Water Supply: well ID ..... 6. <input type="checkbox"/> Dewatering: how many wells? ..... 7. <input type="checkbox"/> Aquifer Recharge: well ID ..... 8. <input type="checkbox"/> Monitoring: well ID .....	10. <input type="checkbox"/> Oil Field Water Supply: lease ..... 11. Test Hole: well ID ..... <input type="checkbox"/> Cased <input type="checkbox"/> Uncased <input type="checkbox"/> Geotechnical 12. Geothermal: how many bores? ..... a) Closed Loop <input type="checkbox"/> Horizontal <input type="checkbox"/> Vertical b) Open Loop <input type="checkbox"/> Surface Discharge <input type="checkbox"/> Inj. of Water 13. <input type="checkbox"/> Other (specify): .....
2. <input type="checkbox"/> Irrigation	9. Environmental Remediation: well ID <b>INJ-27</b> ..... <input checked="" type="checkbox"/> Air Sparge <input type="checkbox"/> Soil Vapor Extraction <input type="checkbox"/> Recovery <input type="checkbox"/> Injection	
3. <input type="checkbox"/> Feedlot		
4. <input type="checkbox"/> Industrial		

Was a chemical/bacteriological sample submitted to KDHE?  Yes  No If yes, date sample was submitted: .....

Water well disinfected?  Yes  No

**8 TYPE OF CASING USED:**  Steel  PVC  Other ..... CASING JOINTS:  Glued  Clamped  Welded  Threaded  
Casing diameter ..... 1 ..... in. to ..... 37 ..... ft., Diameter ..... N/A ..... in. to ..... N/A ..... ft., Diameter ..... N/A ..... in. to ..... N/A ..... ft.  
Casing height above land surface ..... 0 ..... in. Weight ..... N/A ..... lbs./ft. Wall thickness or gauge No. **Sch. 40** .....

**TYPE OF SCREEN OR PERFORATION MATERIAL:**  
 Steel  Stainless Steel  Fiberglass  PVC  Other (Specify) .....  
 Brass  Galvanized Steel  Concrete tile  None used (open hole)

**SCREEN OR PERFORATION OPENINGS ARE:**  
 Continuous Slot  Mill Slot  Gauze Wrapped  Torch Cut  Drilled Holes  Other (Specify) .....  
 Louvered Shutter  Key Punched  Wire Wrapped  Saw Cut  None (Open Hole)

**SCREEN-PERFORATED INTERVALS:** From ..... 37 ..... ft. to ..... 39 ..... ft., From ..... N/A ..... ft. to ..... N/A ..... ft., From ..... N/A ..... ft. to ..... N/A ..... ft.  
**GRAVEL PACK INTERVALS:** From ..... 35 ..... ft. to ..... 40 ..... ft., From ..... N/A ..... ft. to ..... N/A ..... ft., From ..... N/A ..... ft. to ..... N/A ..... ft.

**9 GROUT MATERIAL:**  Neat cement  Cement grout  Bentonite  Other **Concrete 0 to 2 feet** .....

Grout Intervals: From ..... 2 ..... ft. to ..... 35 ..... ft., From ..... N/A ..... ft. to ..... N/A ..... ft., From ..... N/A ..... ft. to ..... N/A ..... ft.

**Nearest source of possible contamination:**  
 Septic Tank  Lateral Lines  Pit Privy  Livestock Pens  Insecticide Storage  
 Sewer Lines  Cess Pool  Sewage Lagoon  Fuel Storage  Abandoned Water Well  
 Watertight Sewer Lines  Seepage Pit  Feedyard  Fertilizer Storage  Oil Well/Gas Well  
 Other (Specify) **Pipeline release site** .....

Direction from well? **South** ..... Distance from well? **<75-feet** ..... ft.

10 FROM	TO	LITHOLOGIC LOG	FROM	TO	LITHO. LOG (cont.) or PLUGGING INTERVALS
0	15	fill			
15	18	concrete former building foundation			
18	40	silt sand			

**Notes:** 1-inch wells constructed with 2-feet of screen with a 1-foot sump at the bottom of the well.

**11 CONTRACTOR'S OR LANDOWNER'S CERTIFICATION:** This water well was  constructed,  reconstructed, or  plugged under my jurisdiction and was completed on (mo-day-year) **6-9-2016** ..... and this record is true to the best of my knowledge and belief. Kansas Water Well Contractor's License No. **759** ..... This Water Well Record was completed on (mo-day-year) **7-4-2016** ..... under the business name of **RAZEK Environmental, LLC** ..... Signature