

WATER WELL PLUGGING RECORD Form WWC-5P KSA 82a-1212 ID NO.


1 LOCATION OF WATER WELL: Fraction 1/4 NE 1/4 SE 1/4 NE 1/4 Section Number 34 Township Number T 10 S Range Number 25 NE W
 County: Wyandotte

Street/Rural Address of Well Location; if unknown, distance & direction from nearest town or intersection: If at owner's address, check here Magellan KC Terminal
 401 E. Donovan Rd.
 Kansas City, KS 62215

Global Positioning Systems (GPS) information:
 Latitude: 39.140998 (in decimal degrees)
 Longitude: -94.603657 (in decimal degrees)
 Elevation: _____
 Horizontal Datum: WGS84, NAD83, NAD27
 Collection Method: _____

2 WATER WELL OWNER: Magellan Midstream Partners,
 RR#, St. Address, Box #: 401 E. Donovan Rd.
 City, State ZIP Code: Kansas City, KS 62215

GPS unit (Make/Model: _____)
 Digital Map/Photo, Topographic Map, Land Survey
 Est. Accuracy: < 3 m, 3-5 m, 5-15 m, > 15 m

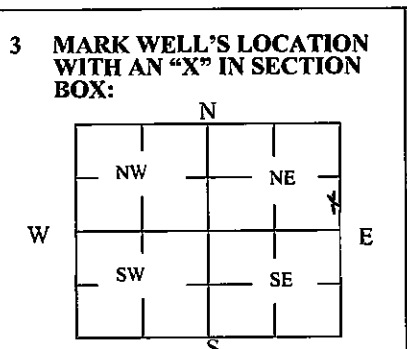

4 DEPTH OF WELL 31 ft.
 WELL'S STATIC WATER LEVEL _____ ft. *well # MPE-053*
 WELL WAS USED AS:
 Domestic Public Water Supply Dewatering
 Irrigation Oil Field Water Supply Monitoring
 Feedlot Domestic (Lawn & Garden) Injection Well
 Industrial Air Conditioning Other _____
 Was a chemical/bacteriological sample submitted to Department? Yes No

5 TYPE OF BLANK CASING USED:
 Steel RMP (SR) Wrought Fiberglass Other (Specify below)
 PVC ABS Asbestos-Cement Concrete Tile
 Blank casing diameter 4 in. Was casing pulled? Yes No If yes, how much All
 Casing height above or below land surface 0 in.

6 GROUT PLUG MATERIAL: Neat cement Cement grout Bentonite Other High Solids
 Grout Plug Intervals: From _____ ft. to _____ ft., From _____ ft. to _____ ft., From _____ ft. to _____ ft.
 What is the nearest source of possible contamination:
 Septic tank Seepage pit Fuel storage Other (specify below)
 Sewer lines Pit privy Fertilizer storage Upgradient Source Plumes
 Watertight sewer lines Sewage lagoon Insecticide storage
 Lateral lines Feedyard Abandoned water well Direction from well? Unknown
 Cess pool Livestock pens Oil well/Gas well How many feet? Unknown

FROM	TO	PLUGGING MATERIALS	FROM	TO	PLUGGING MATERIALS

7 CONTRACTOR'S OR LANDOWNER'S CERTIFICATION: This water well was plugged under my jurisdiction and was completed on (mo/day/year) 9/19/16 and this record is true to the best of my knowledge and belief. Kansas Water Well Contractor's License No. 903. This Water Well Record was completed on (mo/day/year) 10/25/16 under the business name of Roberts Environmental Drilling, Inc. by (signature) [Signature]