

**WATER WELL PLUGGING RECORD Form WWC-5P**

KSA 82a-1212

ID NO.  


<b>1 LOCATION OF WATER WELL:</b> County: Wyandotte	Fraction <u>1/4 SW 1/4 NW 1/4 SW 1/4</u>	Section Number <u>35</u>	Township Number <u>T 10 S</u>	Range Number <u>25</u> <input checked="" type="checkbox"/> E <input type="checkbox"/> W
---	--	--------------------------	-------------------------------	---

Street/Rural Address of Well Location; if unknown, distance & direction from nearest town or intersection: If at owner's address, check here  **Magellan KC Terminal**  
401 E. Donovan Rd.  
Kansas City, KS 62215

**Global Positioning Systems (GPS) information:**  
Latitude: 39.137593 (in decimal degrees)  
Longitude: -94.100889 (in decimal degrees)  
Elevation: \_\_\_\_\_  
Horizontal Datum:  WGS84,  NAD83,  NAD27  
Collection Method: \_\_\_\_\_

**2 WATER WELL OWNER:** Magellan Midstream Partners,  
RR#, St. Address, Box #: 401 E. Donovan Rd.  
City, State ZIP Code: Kansas City, KS 62215

GPS unit (Make/Model: \_\_\_\_\_)  
 Digital Map/Photo,  Topographic Map,  Land Survey  
Est. Accuracy:  < 3 m,  3-5 m,  5-15 m,  > 15 m

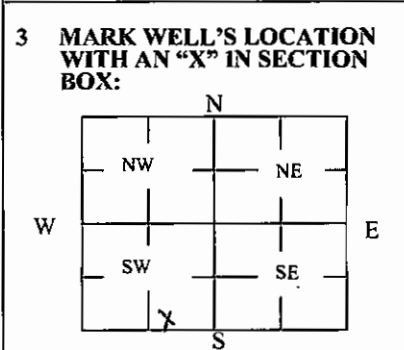

**4 DEPTH OF WELL** 48 ft.  
WELL'S STATIC WATER LEVEL \_\_\_\_\_ ft. well # MW-101  
WELL WAS USED AS:  
 Domestic       Public Water Supply       Dewatering  
 Irrigation       Oil Field Water Supply       Monitoring  
 Feedlot       Domestic (Lawn & Garden)       Injection Well  
 Industrial       Air Conditioning       Other \_\_\_\_\_  
 Was a chemical/bacteriological sample submitted to Department? Yes  No

**5 TYPE OF BLANK CASING USED:**  
 Steel     RMP (SR)     Wrought     Fiberglass     Other (Specify below) \_\_\_\_\_  
 PVC     ABS     Asbestos-Cement     Concrete Tile  
 Blank casing diameter 2 in. Was casing pulled? Yes  No  If yes, how much All  
 Casing height above or below land surface 0 in.

**6 GROUT PLUG MATERIAL:**  Neat cement     Cement grout     Bentonite     Other High Solids  
 Grout Plug Intervals: From \_\_\_\_\_ ft. to \_\_\_\_\_ ft., From \_\_\_\_\_ ft. to \_\_\_\_\_ ft., From \_\_\_\_\_ ft. to \_\_\_\_\_ ft.  
 What is the nearest source of possible contamination:  
 Septic tank     Seepage pit     Fuel storage     Other (specify below) \_\_\_\_\_  
 Sewer lines     Pit privy     Fertilizer storage    Upgradient Source Plumes  
 Watertight sewer lines     Sewage lagoon     Insecticide storage    \_\_\_\_\_  
 Lateral lines     Feedyard     Abandoned water well    Direction from well? Unknown  
 Cess pool     Livestock pens     Oil well/Gas well    How many feet? Unknown

FROM	TO	PLUGGING MATERIALS	FROM	TO	PLUGGING MATERIALS

**7 CONTRACTOR'S OR LANDOWNER'S CERTIFICATION:** This water well was plugged under my jurisdiction and was completed on (mo/day/year) 9/19/16 and this record is true to the best of my knowledge and belief. Kansas Water Well Contractor's License No. 903. This Water Well Record was completed on (mo/day/year) 10/2/16 under the business name of Roberts Environmental Drilling, Inc. by (signature) [Signature]