

WATER WELL RECORD Form WWC-5


Division of Water Resources App. No.

Well ID MW-206C

Original Record Correction Change in Well Use

1 LOCATION OF WATER WELL: County: Wyandotte Fraction NW 1/4 SW 1/4 NW 1/4 NE 1/4 Section Number 27 Township Number T 10 S Range Number R 25 E

2 WELL OWNER: Last Name: Business: General Motors Corporation Address: 100 Kindleberger Road City: Kansas City State: KS ZIP: 66115 Street or Rural Address where well is located

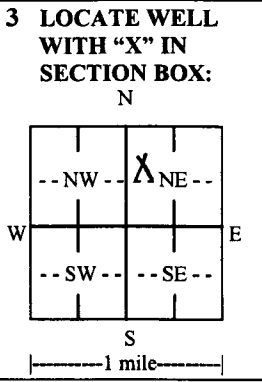

3 LOCATE WELL WITH 'X' IN SECTION BOX: 4 DEPTH OF COMPLETED WELL: 90 ft. Depth(s) Groundwater Encountered: 1) ... 2) ... 3) ... 4) Dry Well

5 Latitude: 39.154735 Longitude: 94.611690 Horizontal Datum: WGS 84 GPS (unit make/model): Land Survey Topographic Map Online Mapper

6 Elevation: Ground Level TOC Source: Land Survey GPS Topographic Map Other

7 WELL WATER TO BE USED AS: 1. Domestic: Household Lawn & Garden Livestock Irrigation Feedlot Industrial 5. Public Water Supply: well ID 6. Dewatering: how many wells? 7. Aquifer Recharge: well ID 8. Monitoring: well ID MW-206C 9. Environmental Remediation: well ID Air Sparge Soil Vapor Extraction Recovery Injection 10. Oil Field Water Supply: lease 11. Test Hole: well ID Cased Uncased Geotechnical 12. Geothermal: how many bores? a) Closed Loop Horizontal Vertical b) Open Loop Surface Discharge Inj. of Water 13. Other (specify):

Was a chemical/bacteriological sample submitted to KDHE? Yes No If yes, date sample was submitted: Water well disinfected? Yes No

8 TYPE OF CASING USED: Steel PVC Other CASING JOINTS: Glued Clamped Welded Threaded Casing diameter: 2 in. to 80 ft. Diameter in. to ft. Diameter in. to ft. Casing height above land surface in. Weight lbs./ft. Wall thickness or gauge No. Sch. 40 TYPE OF SCREEN OR PERFORATION MATERIAL: Steel Stainless Steel Fiberglass PVC Other (Specify) Brass Galvanized Steel Concrete tile None used (open hole) SCREEN OR PERFORATION OPENINGS ARE: Continuous Slot Mill Slot Gauze Wrapped Torch Cut Drilled Holes Other (Specify) Louvered Shutter Key Punched Wire Wrapped Saw Cut None (Open Hole) SCREEN-PERFORATED INTERVALS: From 80 ft. to 90 ft. From ft. to ft. From ft. to ft. GRAVEL PACK INTERVALS: From 78 ft. to 90 ft. From ft. to ft. From ft. to ft.

9 GROUT MATERIAL: Neat cement Cement grout Bentonite Other Concrete Grout Intervals: From 0 ft. to 1 ft. From 1 ft. to 48 ft. From ft. to ft. Nearest source of possible contamination: Septic Tank Lateral Lines Pit Privy Livestock Pens Insecticide Storage Sewer Lines Cess Pool Sewage Lagoon Fuel Storage Abandoned Water Well Watertight Sewer Lines Seepage Pit Feedyard Fertilizer Storage Oil Well/Gas Well Other (Specify) Direction from well? Distance from well? ft.

Table with 6 columns: 10 FROM, TO, LITHOLOGIC LOG, FROM, TO, LITHO. LOG (cont.) or PLUGGING INTERVALS. Rows: 0-2.5 Clay, sandy w/m gravel fill; 2.5-7.5 Clay, w/silt and tr. f sand, Brown; 7.5-10 Clay, silty, w/f sand, Brn Dark Gray; 10-12.5 Clay, sandy (m-f), Brown; 12.5-90 Sand (f), silty, Gray-Brown. Includes Notes section.

11 CONTRACTOR'S OR LANDOWNER'S CERTIFICATION: This water well was constructed, reconstructed, or plugged under my jurisdiction and was completed on (mo-day-year) 9/17/2019 and this record is true to the best of my knowledge and belief. Kansas Water Well Contractor's License No. 527 This Water Well Record was completed on (mo-day-year) 5/7/2020 under the business name of GeoCore, LLC Signature [Signature]

Wyandotte

27-110-R25E



Project Site:  
**Former General Motors Corp., 100 Kindleberger Road, Kansas City**

GPS Coordinates:

MW-200: 39.151692, -94.613351  
 MW-201: 39.155697, -94.614706  
 MW-202: 39.153334, -94.614938  
 MW-203: 39.150406, -94.614568  
 MW-204A: 39.151352, -94.612049  
 MW-204B: 39.151334, -94.612050

MW-205A: 39.150502, -94.611124  
 MW-205B: 39.150500, -94.611100  
 MW-206A: 39.154714, -94.611716  
 MW-206B: 39.154724, -94.611704  
 MW-206C: 39.154735, -94.611690  
 MW-207A: 39.151645, -94.609423

MW-207B: 39.151635, -94.609405  
 MW-207C: 39.151628, -94.609430  
 MW-208A: 39.149778, -94.606494  
 MW-208B: 39.149778, -94.606511  
 MW-208C: 39.149779, -94.606527

**RECEIVED**

JUN 08 2020

BUREAU OF WATER