KOLAR Document ID: 1525688

AS-218

WATER WELL PLUGGING RECORD Form WWC-5P KSA 82a-1212 ID NO.

1 LOCATION OF WATER WELL: County: Wyandotte | Fraction: SW ¼ NE ¼ SW ¼ SW ¼ | Section Number: 27 | Township Number: 10 T S | Range Number: 25 ☐ E ☐ W

Street/Rural Address of Well Location; if unknown, distance & direction from nearest town or intersection: If at owner's address, check here ☐ 3150 DODGE RD KANSAS CITY, KS

Global Positioning Systems (GPS) information:
Latitude: 39.144970 (in decimal degrees)
Longitude: 94.619048 (in decimal degrees)
Elevation: 745
Datum: ☑ WGS84, ☐ NAD83, ☐ NAD27
Collection Method:
☐ GPS unit (Make/Model: _____)
☑ Digital Map/Photo, ☐ Topographic Map, ☐ Land Survey
Est. Accuracy: ☑ < 3 m, ☐ 3-5 m, ☐ 5-15 m, ☐ > 15 m

2 WATER WELL OWNER: FORMER UNISON TRANSFOR
RR#, St. Address, Box #: 3126 BRINKERHOFF RD
City, State ZIP Code: KANSAS CITY KANSAS 66115

3 MARK WELL'S LOCATION WITH AN "X" IN SECTION BOX:

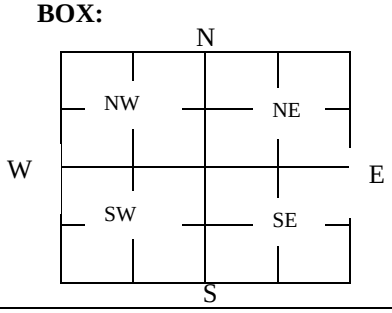

4 DEPTH OF WELL 80.2 **ft.**

WELL'S STATIC WATER LEVEL 13.81 ft

WELL WAS USED AS:

☐ Domestic ☐ Irrigation ☐ Feedlot ☐ Industrial
☐ Public Water Supply ☐ Oil Field Water Supply ☐ Domestic (Lawn & Garden) ☐ Air Conditioning
☐ Dewatering ☐ Monitoring ☐ Injection Well ☑ Other AIR SPARGE

Was a chemical/bacteriological sample submitted to Department? Yes ☐ No ☑

5 TYPE OF BLANK CASING USED:

☐ Steel ☑ PVC ☐ RMP (SR) ☐ ABS ☐ Wrought ☐ Asbestos-Cement ☐ Fiberglass ☐ Concrete Tile ☐ Other (Specify below) _____

Blank casing diameter 1 in. Was casing pulled? Yes ☐ No ☑ If yes, how much _____
Casing height above or below land surface -36 in.

6 GROUT PLUG MATERIAL: ☐ Neat cement ☑ Cement grout ☐ Bentonite ☐ Other _____

Grout Plug Intervals: From -3 ft. to 80.2 ft., From _____ ft. to _____ft., From _____ ft. to _____ ft.

What is the nearest source of possible contamination:

☐ Septic tank ☑ Sewer lines ☐ Watertight sewer lines ☐ Lateral lines ☐ Cess pool
☐ Seepage pit ☐ Pit privy ☐ Sewage lagoon ☐ Feedyard ☐ Livestock pens
☐ Fuel storage ☐ Fertilizer storage ☐ Insecticide storage ☐ Abandoned water well ☐ Oil well/Gas well
☐ Other (specify below) _____
Direction from well? EAST
How many feet? 155

FROM	TO	PLUGGING MATERIALS	FROM	TO	PLUGGING MATERIALS

7 CONTRACTOR'S OR LANDOWNER'S CERTIFICATION: This water well was plugged under my jurisdiction and was completed on (mo/day/year) 6/26/2020 and this record is true to the best of my knowledge and belief. Kansas Water Well Contractor's License No. 753. This Water Well Record was completed on (mo/day/year) 8/4/2020 under the business name of ENVIRONMENTAL WORKS INC by (signature) _____

Send one white copy to Kansas Department of Health & Environment, Geology Section, 1000 SW Jackson Street, Ste. 420, Topeka, KS 66612-1367. Send one copy to WATER WELL OWNER and retain one for your records.
Visit us at http://www.kdheks.gov/waterwell/index.html Telephone 785-296-5524.

KSA82a-1212 **Revised 1/29/2014**