
WATER WELL PLUGGING I	RECORD Form WW	C-5P KSA 82	a-1212 ID NO.	INA-11
1 LOCATION OF WATER WELL: County: Wyandotte	Fraction 1/4 sw 1/4 sw 1/4 ne 1/2	Section Number	Township Number T 10 S	Range Number 25 E W
Street/Rural Address of Well Location; if unknown, distance & Global Positioning Systems (GPS) information:				
direction from nearest town or intersection: If at owner's address, check here Former INX Facility Stanley Rd. and Chrysler Kansas City, 66115		Latitude: 39.13589 Longitude: -94.609 Elevation: 735 Horizontal Datum: Collection Method:	88	(in decimal degrees)(in decimal degrees)  NAD83,  NAD27
2 WATER WELL OWNER: INX International Ink Co.				
RR#, St. Address, Box #: 150 N. Martingale Rd., Ste. 700 City, State ZIP Code: Schaumberg, IL 60173		Digital Map/Photo, Topographic Map, Land Survey		
City, State ZIP Code: Schaumberg, IL 60173  Est. Accuracy:				
3 MARK WELL'S LOCATION WITH AN "X" IN SECTION BOX:  WELL'S STATIC WATER LEVEL 17.60  WELL WAS USED AS:  Domestic Irrigation Oil Field Water Supply Oil Field Water Supply Domestic (Lawn & Garden) Industrial  Was a chemical/bacteriological sample submitted to Department? Yes No				
Steel RMP (SR) Wrought Concrete Tile  Blank casing diameter 2 in. Was casing pulled? Yes No If yes, how much Top 3-feet  Casing height above or below land surface 0 in.  6 GROUT PLUG MATERIAL: Neat cement Cement grout Bentonite Other Topsoil and grass seed  Grout Plug Intervals: From 3 ft. to 29.70 ft., From N/A ft. to N/A ft., From N/A ft. to N/A ft.  What is the nearest source of possible contamination:  Septic tank Seepage pit Fuel storage Other (specify below)				
Sewer lines Pit privy Fertilizer storage				
Watertight sewer lines Sewage lagoon Insecticide storage Lateral lines Feedyard Abandoned water well Direction from well? Adjacent Cess pool Livestock pens Oil well/Gas well How many feet? O-feet				
FROM TO PLUC	GGING MATERIALS	FROM TO	PLUGGING	MATERIALS
0 3 Topsoil/gra				
3 29.70 Bentonite (				
7 CONTRACTOR'S OR LANDOWNER'S CERTIFICATION: This water well was plugged under my jurisdiction and was completed on (mo/day/year) 8/30/2021 and this record is true to the best of my knowledge and belief. Kansas Water Well Contractor's License No. 759 . This Water Well Record was completed on (mo/day/year) 9/23/2021 under the business name of RAZEK Environmental, LLC by (signature)				
Send one white copy to Kansas Department of Health & Environment, Geology Section, 1000 SW Jackson Street, Ste. 420, Topeka, KS 66612-1367. Send one copy to WATER WELL OWNER and retain one for your records.  Visit us at <a href="http://www.kdheks.gov/waterwell/index.html">http://www.kdheks.gov/waterwell/index.html</a> Telephone 785-296-5524.  KSA82a-1212  Revised 1/20/2015				

INX-11

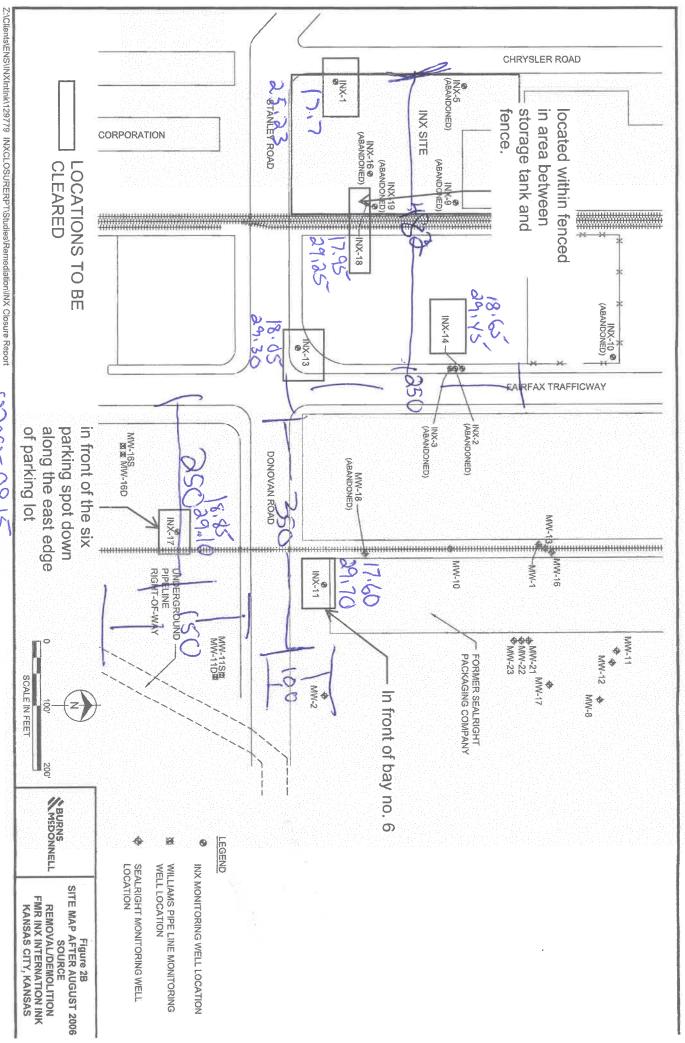


C700-0815