

WATER WELL RECORD

Form WWC-5

Division of Water Resources App. No.


Well ID

MW3

Original Record Correction Change in Well Use

1 LOCATION OF WATER WELL: County Wyandotte Fraction NE 1/4 NE 1/4 NW 1/4 SW 1/4 Section Number 27 Township Number T 10 S Range Number R 25 E W

2 WELL OWNER: Last Name: Business: World Fuel Services Address: 401 Kindleberger Road City Kansas City State: KS ZIP: 66115 Street or Rural Address where well is located (if unknown, distance and direction from nearest town or intersection): If at owner's address, check here: X

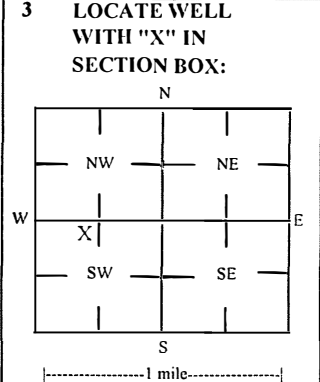

3 LOCATE WELL WITH 'X' IN SECTION BOX: 4 DEPTH OF COMPLETED WELL: 35 ft Depth(s) Groundwater Encountered: 1) 26 ft 2) ft 3) ft, or 4) Dry Well WELL'S STATIC WATER LEVEL: NA ft. below land surface, measured on (mo-day-yr) above land surface, measured on (mo-day-yr) Pump test data: Well water was ft after hours pumping gpm Water well was ft after hours pumping gpm Estimated Yield: gpm Bore Hole Diameter: 7.25 in to ft, and in to ft

5 Latitude: 39.1497 (decimal degrees) Longitude: -94.61782 (decimal degrees) Horizontal Datum: X WGS 84 NAD 83 NAD 27 Source for Latitude/Longitude: GPS (unit make/model: ) (WAAS enabled? Yes No) X Land Survey Topographic Map Online Mapper

6 Elevation 747.00 ft Ground Level X TOC Source: X Land Survey GPS Topographic Map Other

7 WELL WATER TO BE USED AS: 1 Domestic: Household Lawn & Garden Livestock Irrigation Feedlot Industrial 2 Public Water Supply: well ID 3 Dewatering: how many wells? 4 Aquifer Recharge: well ID 5 Monitoring: well ID MW3 6 Environmental Remediation: well ID Air Sparge Soil Vapor Extractor Recovery Injection 7 Oil Field Water Supply: lease 8 Test Hole: well ID Cased Uncased Geotechnical 9 Geothermal: How many bores? a) Closed Loop Horizontal Vertical b) Open Loop Surface Discharge Inj. of Water Other (specify):

Was a chemical/bacteriological sample submitted to KDHE? Yes No X No If yes, date sample was submitted: Water well disinfected? Yes No X No

8 TYPE OF CASING USED: Steel PVC Other CASING JOINTS: Glued Clamped Welded X Threaded Casing diameter 2 in. to 20 ft, Diameter in. to ft, Diameter in. to ft, Casing height above land surface -0.29 in. Weight lbs./ft. Well thickness or gauge No TYPE OF SCREEN OR PERFORATION MATERIAL: Steel Stainless Steel Fiberglass PVC Other (Specify) Brass Galvanized Steel Concrete tile None used (open hole) SCREEN OR PERFORATION OPENINGS ARE: Continuous Slot X Mill Slot Gauze Wrapped Torch Cut Drilled Holes Other (Specify) Louvered Shutter Key Punched Wire Wrapped Saw Cut None (Open Hole) SCREEN-PERFORATED INTERVALS: From 20 ft. to 35 ft, From ft. to ft, From ft. to ft, GRAVEL PACK INTERVALS: From 18 ft. to 35 ft, From ft. to ft, From ft. to ft,

9 GROUT MATERIAL: Neat cement Cement grout X Bentonite X Other Concrete: 0-1' Grout intervals: From 1 ft. to 18 ft, From ft. to ft, From ft. to ft,

Nearest source of possible contamination: Septic Tank Lateral Lines Pit Privy Livestock Pens Insecticide Storage Sewer Lines Cess Pool Sewage Lagoon X Fuel Storage Abandoned Water Well Watertight Sewer Lines Seepage Pit Feedyard Fertilizer Storage Oil Well / Gas Well Other (Specify) Direction from well? E-SE Distance from well? ~150 ft

Table with 6 columns: 10 FROM, TO, LITHOLOGIC LOG, FROM, TO, LITHO. LOG (cont.) or PLUGGING INTERVALS. Rows include Topsoil, grass; Silty lean clay; Clayey silt; Silty fat clay; Sand, fine grained.

Notes: KDHE ID: World Fuel Services; A4-105-40512 Target of monitoring well is shallow groundwater, <20' of grout was installed at the direction of KDHE.

11 CONTRACTOR'S OR LANDOWNER'S CERTIFICATION: This water well was X constructed, reconstructed or plugged under my jurisdiction and was completed on (mo-day-year) 6/20/23 and this record is true to the best of my knowledge and belief. Kansas Water Well Contractor's License No 757 This Water Well Record was completed on (mo-day-year) 7/27/23 under the business name of Larsen & Associates, Inc. Signature

July 26, 2023  
 Blackstone Environmental,  
 Inc. Theresa Ferguson  
 16200 Foster Street  
 Overland Park, KS 66085

T. 10 R.25E Sec.27  
 Wyandotte County

RE: Project No. A4-105-40512

Theresa,

The following is the information requested on a Monitoring Well Site, City of Kansas City, World Fuel Services, 401 Kindleberger Rd., Wyandotte County, Kansas.

Point	North Coord.	East Coord.	Dist. South of W/4 Cor.	Dist. East of W/4 Cor.	Elev. Top of Rim "V" cut East Side	Elev. Top of Casing Pipe	Latitude North	Longitude West
W/4 Cor.	5000	5000						
MW1	4760.30	6318.97	239.70	1318.97	748.30	747.99	39.14956	-94.61729
MW2	4662.95	6170.02	337.05	1170.02	748.04	747.77	39.14929	-94.61782
MW3	4814.90	6126.08	185.10	1126.08	747.29	747.00	39.1497	-94.61797
MW4	4763.71	6243.24	236.29	1243.24	748.27	747.93	39.14956	-94.61756
MW5	4718.62	6420.28	281.38	1420.28	747.76	747.26	39.14944	-94.61693
MW6	4834.26	6283.66	165.74	1283.66	749.08	748.80	39.14976	-94.61742
MW7	4837.29	6416.96	162.71	1416.96	747.36	746.94	39.14977	-94.61695
MW8	4917.45	6396.39	82.55	1396.39	747.61	747.33	39.14999	-94.61702
MW9	4646.44	6237.14	353.56	1237.14	748.36	747.88	39.14924	-94.61758

**Description:**

"V" cut on top of each rim on the east side of the valve box. Also, all measurement was made on the east side of the pvc casing pipe.

**Project information:** West ¼ Cor. Sec. 27, T10S,R25E was assumed coord at N-5000,E-5000

Field work was completed with an Emlid-ReachRS2+ ant. With an opus solution: 81% fixed AMB and overall RMS of 0.011m.

**Location of Monitoring Wells in the Public Land Survey System (PLSS):**

MW- 1,3,4,6 :NE1/4,NE1/4,NW1/4,SW1/4 Sec. 27, T10S, R25E

MW- 2,9 :SE1/4,NE ¼,NW1/4,SW1/4 Sec. 27, T10S, R25E

MW- 5,7,8 :NW1/4,NW ¼,NE1/4,SW1/4 Sec. 27, T10S, R25E


All field work was completed on July 19, 2023, under my direct supervision. If you have any questions, please contact me at your convenience.

Sincerely,



M. Wayne Blackbourn, PE,PS.  
 Senior Project Engineer

RECEIVED  
 JUL 31 2023  
 BUREAU OF WATER

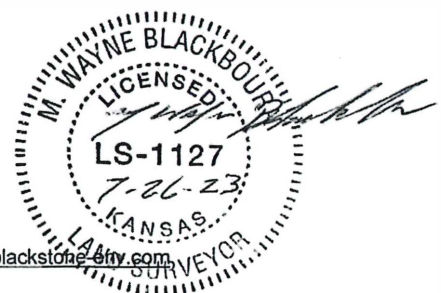



Maxar, Microsoft, Esri, HERE, Garmin, iPC

Site Boundary	DEF UST	Proposed Geotechnical Boring	Groundwater Flow Direction
Parcel Boundary	Power	Proposed Soil Boring	
On Site Building	Sanitary Sewer	Proposed Monitoring Well	
Canopy & Dispensers	Stormwater	Commercial/ Industrial	
AST	Product Lines		

T. 10 R.25E Sec.27  
Wyandotte County

0 31.25 62.5 125 Feet

<b>FIGURE</b> <b>2.2</b>	Project Mgr. TF	Date: 5/23 2023		SHEET NAME	Detailed Site Map	PROJECT NAME	World Fuel Services
	Designed By: MO	Rev.:		PROJECT NAME	LSA	KDHE PROJECT CODE	A4-105-40512
	Drawn By: MO	Rev.:		PROJECT LOCATION	401 Kindeberger Road, Kansas City, KS	SCALE	1"= 125'
	Checked By: TF	Rev.:					
	Job No.: 3397.01	Rev.:					