


1 LOCATION OF WATER WELL: Fraction **SW 1/4 SE 1/4 SW 1/4** Section Number **15** Township Number **T 10 S** Range Number **9**
 County: **Wyandotte**
 Distance and direction from nearest town or city street address of well if located within city?
401 E Donavan Kansas City Ks

2 WATER WELL OWNER: **Williams Pipeline**
 RR#, St. Address, Box #: **Fairfax Facility**
 City, State, ZIP Code: **Kansas City Ks.**
 Board of Agriculture, Division of Water Resources
 Application Number:

3 LOCATE WELL'S LOCATION WITH AN "X" IN SECTION BOX:

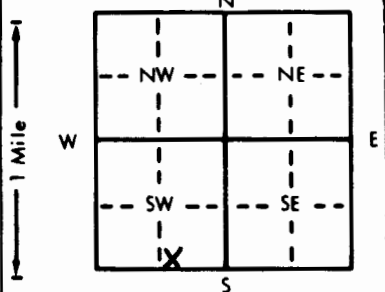

4 DEPTH OF COMPLETED WELL: **29.5** ft. ELEVATION: **-**
 Depth(s) Groundwater Encountered 1. **14.81** ft. 2. **-** ft. 3. **-** ft.
 WELL'S STATIC WATER LEVEL **14.81** ft. below land surface measured on mo/day/yr **10-27-93**
 Pump test data: Well water was **-** ft. after **-** hours pumping **-** gpm
 Est. Yield **-** gpm: Well water was **-** ft. after **-** hours pumping **-** gpm
 Bore Hole Diameter **10** in. to **29.5** ft., and **-** in. to **-** ft.
 WELL WATER TO BE USED AS:
 5 Public water supply 8 Air conditioning 11 Injection well
 1 Domestic 3 Feedlot 6 Oil field water supply 9 Dewatering 12 Other (Specify below)
 2 Irrigation 4 Industrial 7 Lawn and garden only Monitoring well
 Was a chemical/bacteriological sample submitted to Department? Yes **-** No If yes, mo/day/yr sample was submitted
 Water Well Disinfected? Yes **-** No

5 TYPE OF BLANK CASING USED:
 1 Steel PVC
 3 RMP (SR) 4 ABS
 5 Wrought iron 6 Asbestos-Cement 7 Fiberglass
 8 Concrete tile 9 Other (specify below)
 CASING JOINTS: Glued **-** Clamped **-**
 Welded **-** Threaded
 Blank casing diameter **4"** in. to **9.5** ft., Dia **-** in. to **-** ft., Dia **-** in. to **-** ft.
 Casing height above land surface **2.5** in., weight **Sch 40** lbs./ft. Wall thickness or gauge No. **-**
 TYPE OF SCREEN OR PERFORATION MATERIAL:
 1 Steel 3 Stainless steel 5 Fiberglass 8 RMP (SR) 10 Asbestos-cement 11 Other (specify)
 2 Brass 4 Galvanized steel 6 Concrete tile 9 ABS 12 None used (open hole)
 SCREEN OR PERFORATION OPENINGS ARE:
 1 Continuous slot Mill slot
 2 Louvered shutter 4 Key punched 5 Gauzed wrapped 8 Saw cut 11 None (open hole)
 6 Wire wrapped 9 Drilled holes
 7 Torch cut 10 Other (specify)
 SCREEN-PERFORATED INTERVALS: From **9.5** ft. to **29.5** ft., From **-** ft. to **-** ft., From **-** ft. to **-** ft.
 GRAVEL PACK INTERVALS: From **7.5** ft. to **29.5** ft., From **-** ft. to **-** ft., From **-** ft. to **-** ft.

6 GROUT MATERIAL: Neat cement 2 Cement grout Bentonite 4 Other **-**
 Grout Intervals: From **0.0** ft. to **7.5** ft., From **-** ft. to **-** ft., From **-** ft. to **-** ft.
 What is the nearest source of possible contamination:
 1 Septic tank 4 Lateral lines 7 Pit privy 10 Livestock pens 14 Abandoned water well
 2 Sewer lines 5 Cess pool 8 Sewage lagoon 11 Fuel storage 15 Oil well/Gas well
 3 Watertight sewer lines 6 Seepage pit 9 Feedyard 12 Fertilizer storage 16 Other (specify below)
 13 Insecticide storage
 Direction from well? How many feet?

FROM	TO	LITHOLOGIC LOG	FROM	TO	PLUGGING INTERVALS
0.0	2.0	Silty clay Gr Br			
2.0	10.5	Silt. DK Gr			
10.5	29.9	Silty sand DK Gr			

7 CONTRACTOR'S OR LANDOWNER'S CERTIFICATION: This water well was constructed, (2) reconstructed, or (3) plugged under my jurisdiction and was completed on (mo/day/year) **10-4-93** and this record is true to the best of my knowledge and belief. Kansas Water Well Contractor's License No. **4116** This Water Well Record was completed on (mo/day/yr) **1-3-94** under the business name of **Terracon Consultants Inc** by (signature) **Richard D. Murphy**

INSTRUCTIONS: Use typewriter or ball point pen. PLEASE PRESS FIRMLY and PRINT clearly. Please fill in blanks, underline or circle the correct answers. Send top three copies to Kansas Department of Health and Environment, Bureau of Water, Topeka, Kansas 66620-7320. Telephone: 913-296-5545. Send one to WATER WELL OWNER and retain one for your records.

OFFICE USE ONLY