


1 LOCATION OF WATER WELL: Fraction SW 1/4 SE 1/4 SW 1/4 Section Number 15 Township Number T 10 S Range Number 25 E  
 County: Wyandotte

Distance and direction from nearest town or city street address of well if located within city?  
 401 E Donguan Kansas City Ks

2 WATER WELL OWNER: Williams Pipeline  
 RR#, St. Address, Box #: Fairfax Facility  
 City, State, ZIP Code: Kansas City Ks.  
 Board of Agriculture, Division of Water Resources  
 Application Number:

3 LOCATE WELL'S LOCATION WITH AN "X" IN SECTION BOX:

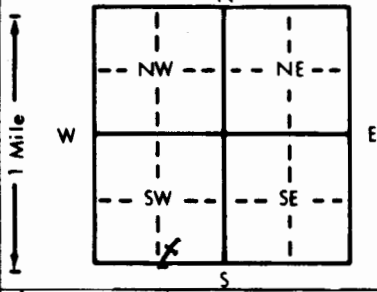

4 DEPTH OF COMPLETED WELL: 32 ft. ELEVATION: —  
 Depth(s) Groundwater Encountered 1. 14.27 ft. 2. — ft. 3. — ft.  
 WELL'S STATIC WATER LEVEL 14.27 ft. below land surface measured on mo/day/yr 10-27-93  
 Pump test data: Well water was — ft. after — hours pumping — gpm  
 Est. Yield — gpm: Well water was — ft. after — hours pumping — gpm  
 Bore Hole Diameter: 10 in. to 33 ft., and — in. to — ft.  
 WELL WATER TO BE USED AS:  
 5 Public water supply 8 Air conditioning 11 Injection well  
 1 Domestic 3 Feedlot 6 Oil field water supply 9 Dewatering 12 Other (Specify below)  
 2 Irrigation 4 Industrial 7 Lawn and garden only 10 Monitoring well  
 Was a chemical/bacteriological sample submitted to Department? Yes — No X; If yes, mo/day/yr sample was submitted  
 Water Well Disinfected? Yes — No X

5 TYPE OF BLANK CASING USED:  
 1 Steel 3 RMP (SR) 5 Wrought iron 8 Concrete tile CASING JOINTS: Glued — Clamped —  
 2 PVC 4 ABS 6 Asbestos-Cement 9 Other (specify below) Welded —  
 7 Fiberglass Threaded X

Blank casing diameter 4 in. to 12.0 ft., Dia — in. to — ft., Dia — in. to — ft.  
 Casing height above land surface 2.5 in., weight SCH 40 lbs./ft. Wall thickness or gauge No. —

TYPE OF SCREEN OR PERFORATION MATERIAL:  
 1 Steel 3 Stainless steel 5 Fiberglass 8 RMP (SR) 10 Asbestos-cement  
 2 Brass 4 Galvanized steel 6 Concrete tile 9 ABS 11 Other (specify) —  
 12 None used (open hole)

SCREEN OR PERFORATION OPENINGS ARE:  
 1 Continuous slot 2 Mill slot 3 Gauzed wrapped 4 Saw cut 5 None (open hole)  
 2 Louvered shutter 4 Key punched 6 Wire wrapped 9 Drilled holes  
 7 Torch cut 10 Other (specify) —

SCREEN-PERFORATED INTERVALS: From 12.0 ft. to 32 ft., From — ft. to — ft.  
 From — ft. to — ft., From — ft. to — ft.  
 GRAVEL PACK INTERVALS: From 9.0 ft. to 32.0 ft., From — ft. to — ft.  
 From — ft. to — ft., From — ft. to — ft.

6 GROUT MATERIAL: 1 Neat cement 2 Cement grout 3 Bentonite 4 Other  
 Grout Intervals: From 0.0 ft. to 9.0 ft., From — ft. to — ft., From — ft. to — ft.

What is the nearest source of possible contamination:  
 1 Septic tank 4 Lateral lines 7 Pit privy 10 Livestock pens 14 Abandoned water well  
 2 Sewer lines 5 Cess pool 8 Sewage lagoon 11 Fuel storage 15 Oil well/Gas well  
 3 Watertight sewer lines 6 Seepage pit 9 Feedyard 12 Fertilizer storage 16 Other (specify below)  
 13 Insecticide storage

Direction from well? How many feet?

FROM	TO	LITHOLOGIC LOG	FROM	TO	PLUGGING INTERVALS
0.0	1.0	Gravel DK Gr			
1.0	4.5	Silty clay Gr Br			
4.5	6.0	Silt Olive Gr			
6.0	7.2	Sand Olive Gr			
7.2	32.0	Silt DK Gr			

7 CONTRACTOR'S OR LANDOWNER'S CERTIFICATION: This water well was 1 constructed, (2) reconstructed, or (3) plugged under my jurisdiction and was completed on (mo/day/year) 10-7-93 and this record is true to the best of my knowledge and belief. Kansas Water Well Contractor's License No. 416 This Water Well Record was completed on (mo/day/yr) 1-4-94 under the business name of Terracon Consultants Inc by (signature) Richard D. Murray