


#3

1 LOCATION OF WATER WELL: County: Wyandotte Fraction: SW 1/4 SW 1/4 SE 1/4 Section Number: 22 Township Number: T 10 S Range Number: R 25 E/W

Distance and direction from nearest town or city street address of well if located within city?
Located in Kansas City, Kansas - east of the Fairfax Bridge between Mo. River and levee

2 WATER WELL OWNER: U.S. Environmental Protection Agency
 RR#, St. Address, Box #: 25 Funston Road
 City, State, ZIP Code: Kansas City, Kansas 66101 #3
 Board of Agriculture, Division of Water Resources
 Application Number:

3 LOCATE WELL'S LOCATION WITH AN "X" IN SECTION BOX:

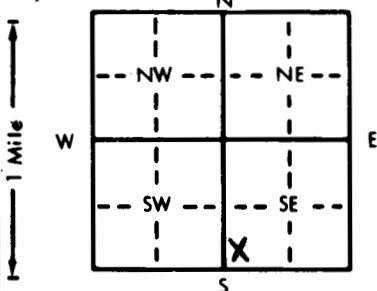

4 DEPTH OF COMPLETED WELL: 28.5 ft. ELEVATION:
 Depth(s) Groundwater Encountered 1. 20.5 ft. 2. ft. 3. ft.
 WELL'S STATIC WATER LEVEL 20.0 ft. below land surface measured on mo/day/yr 10/8/81
 Pump test data: Well water was ft. after hours pumping gpm
 Est. Yield gpm: Well water was ft. after hours pumping gpm
 Bore Hole Diameter in. to ft. and in. to ft.
 WELL WATER TO BE USED AS: 5 Public water supply 8 Air conditioning 11 Injection well
 1 Domestic 3 Feedlot 6 Oil field water supply 9 Dewatering 12 Other (Specify below)
 2 Irrigation 4 Industrial 7 Lawn and garden only 10 Observation well Monitoring Well
 Was a chemical/bacteriological sample submitted to Department? Yes No X; If yes, mo/day/yr sample was submitted
 Water Well Disinfected? Yes No

5 TYPE OF BLANK CASING USED:
 1 Steel 3 RMP (SR) 5 Wrought iron 8 Concrete tile CASING JOINTS: Glued Clamped
 2 PVC 4 ABS 6 Asbestos-Cement 9 Other (specify below) Welded
 7 Fiberglass Threaded
 Blank casing diameter 2.0 in. to 18.5 ft., Dia. in. to ft., Dia. in. to ft.
 Casing height above land surface 18 in., weight lbs./ft. Wall thickness or gauge No. SCH 80

TYPE OF SCREEN OR PERFORATION MATERIAL:
 1 Steel 3 Stainless steel 5 Fiberglass 7 PVC 10 Asbestos-cement
 2 Brass 4 Galvanized steel 6 Concrete tile 8 RMP (SR) 11 Other (specify)
 12 None used (open hole)

SCREEN OR PERFORATION OPENINGS ARE:
 1 Continuous slot 3 Mill slot 5 Gauzed wrapped 8 Saw cut 11 None (open hole)
 2 Louvered shutter 4 Key punched 6 Wire wrapped 9 Drilled holes
 7 Torch cut 10 Other (specify)

SCREEN-PERFORATED INTERVALS: From 18.5 ft. to 28.5 ft., From ft. to ft.
 GRAVEL PACK INTERVALS: From 18.5 ft. to 28.5 ft., From ft. to ft.

6 GROUT MATERIAL: 1 Neat cement 2 Cement grout 3 Bentonite 4 Other
 Grout Intervals: From 18.5 ft. to surface ft., From ft. to ft., From ft. to ft.

What is the nearest source of possible contamination:
 1 Septic tank 4 Lateral lines 7 Pit privy 10 Livestock pens 14 Abandoned water well
 2 Sewer lines 5 Cess pool 8 Sewage lagoon 11 Fuel storage 15 Oil well/Gas well
 3 Watertight sewer lines 6 Seepage pit 9 Feedyard 12 Fertilizer storage 16 Other (specify below)
 13 Insecticide storage Abandoned waste dump
 Direction from well? major portion - south How many feet? 0-(see log below)

FROM	TO	LITHOLOGIC LOG	FROM	TO	LITHOLOGIC LOG
0.0	2.0	Gray Brown Sandy Silt, moist, loose			
2.0	12.2	same but mixed with debris fill (rubber trimming broken brickbats at 4' to 6')			
12.2	13.5	Gray Clayey Silt, moist, loose			
13.5	18.0	same, becoming silty			
18.0	23.0	Gray Clayey Silt, very moist, soft			
23.0	33.0	Gray Silty Sand, wet, medium			
	33.0	Drilling Discontinued			

7 CONTRACTOR'S OR LANDOWNER'S CERTIFICATION: This water well was (1) constructed, (2) reconstructed, or (3) plugged under my jurisdiction and was completed on (mo/day/year) 9/29/81 and this record is true to the best of my knowledge and belief. Kansas Water Well Contractor's License No. This Water Well Record was completed on (mo/day/yr) 10/21/81 under the business name of U.S. EPA by (signature) William N. Longston

INSTRUCTIONS: Use typewriter or ball point pen, PLEASE PRESS FIRMLY and PRINT clearly. Please fill in blanks, underline or circle the correct answers. Send top three copies to Kansas Department of Health and Environment, Division of Environment, Environmental Geology Section, Topeka, KS 66620. Send one to WATER WELL OWNER and retain one for your records.

OFFICE USE ONLY
T 10 R 25 DW SEC. 22 SW 1/4 SW 1/4 SE 1/4