


1 LOCATION OF WATER WELL: County: **Wyandotte** Fraction: **NE 1/4 SW 1/4 SE 1/4** Section Number: **22** Township Number: **T 10 S** Range Number: **R 25 E/W**

Distance and direction from nearest town or city street address of well if located within city?
In Kansas City, Kansas - East of Fairfax Bridge between Mo. River and Levee

2 WATER WELL OWNER: **U.S. Environmental Protection Agency** Board of Agriculture, Division of Water Resources
 RR#, St. Address, Box #: **25 Funston Road** Application Number:
 City, State, ZIP Code: **Kansas City, Kansas 66101 #2**

3 LOCATE WELL'S LOCATION WITH AN "X" IN SECTION BOX:

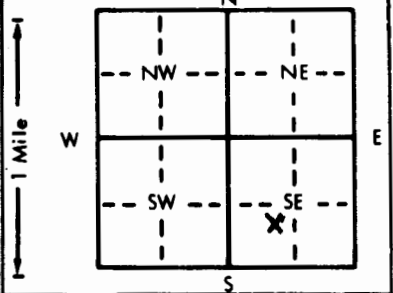

4 DEPTH OF COMPLETED WELL: **26.0** ft. ELEVATION:
 Depth(s) Groundwater Encountered 1. **19.8** ft. 2. ft. 3. ft.
 WELL'S STATIC WATER LEVEL: **20.0** ft. below land surface measured on **mo/day/yr 10/8/81**
 Pump test data: Well water was ft. after hours pumping gpm
 Est. Yield gpm: Well water was ft. after hours pumping gpm
 Bore Hole Diameter in. to ft., and in. to ft.
 WELL WATER TO BE USED AS:
 5 Public water supply 8 Air conditioning 11 Injection well
 1 Domestic 3 Feedlot 6 Oil field water supply 9 Dewatering 12 Other (Specify below)
 2 Irrigation 4 Industrial 7 Lawn and garden only 10 Observation well **Monitoring Well**
 Was a chemical/bacteriological sample submitted to Department? Yes No **X**; If yes, mo/day/yr sample was submitted
 Water Well Disinfected? Yes No

5 TYPE OF BLANK CASING USED:
 1 Steel 3 RMP (SR) 5 Wrought iron 8 Concrete tile CASING JOINTS: Glued Clamped
 2 PVC 4 ABS 6 Asbestos-Cement 9 Other (specify below) Welded
 7 Fiberglass Threaded

Blank casing diameter **2.0** in. to **16.0** ft., Dia. in. to ft., Dia. in. to ft.
 Casing height above land surface **48** in., weight lbs./ft. Wall thickness or gauge No. **SCH 80**

TYPE OF SCREEN OR PERFORATION MATERIAL:
 1 Steel 3 Stainless steel 5 Fiberglass 7 PVC 10 Asbestos-cement
 2 Brass 4 Galvanized steel 6 Concrete tile 8 RMP (SR) 11 Other (specify)
 9 ABS 12 None used (open hole)

SCREEN OR PERFORATION OPENINGS ARE:
 1 Continuous slot 3 Mill slot 5 Gauzed wrapped 8 Saw cut 11 None (open hole)
 2 Louvered shutter 4 Key punched 6 Wire wrapped 9 Drilled holes
 7 Torch cut 10 Other (specify)

SCREEN-PERFORATED INTERVALS: From **16.0** ft. to **26.0** ft., From ft. to ft.
 GRAVEL PACK INTERVALS: From **16.0** ft. to **26.0** ft., From ft. to ft.

6 GROUT MATERIAL: 1 Neat cement 2 Cement grout 3 Bentonite 4 Other
 Grout Intervals: From **16.0** ft. to **surface** ft., From ft. to ft., From ft. to ft.

What is the nearest source of possible contamination:
 1 Septic tank 4 Lateral lines 7 Pit privy 10 Livestock pens 14 Abandoned water well
 2 Sewer lines 5 Cess pool 8 Sewage lagoon 11 Fuel storage 15 Oil well/Gas well
 3 Watertight sewer lines 6 Seepage pit 9 Feedyard 12 Fertilizer storage 16 Other (specify below)
 13 Insecticide storage **Abandoned waste dump**

Direction from well? **Major portion - southwest** How many feet? **0 (see log below)**

FROM	TO	LITHOLOGIC LOG	FROM	TO	LITHOLOGIC LOG
0.0	1.2	Gray-White Sandy Silt (runoff alluvium)			
1.2	11.8	Gray Silt with trash (fill)			
11.8	22.1	Gray Silt, very moist, loose			
22.1	28.0	Gray Silty Sand, fine, mucky, loose			
	28.0	Drilling Discontinued			

7 CONTRACTOR'S OR LANDOWNER'S CERTIFICATION: This water well was (1) constructed, (2) reconstructed, or (3) plugged under my jurisdiction and was completed on (mo/day/year) **9/28/81** and this record is true to the best of my knowledge and belief. Kansas Water Well Contractor's License No. This Water Well Record was completed on (mo/day/yr) **10/21/81** under the business name of **U.S. EPA** by (signature) *William N. Sogther*

INSTRUCTIONS: Use typewriter or ball point pen, PLEASE PRESS FIRMLY and PRINT clearly. Please fill in blanks, underline or circle the correct answers. Send top three copies to Kansas Department of Health and Environment, Division of Environment, Environmental Geology Section, Topeka, KS 66620. Send one to WATER WELL OWNER and retain one for your records.

OFFICE USE ONLY T 10 R 25 LEW SEC. 22 NE 1/4 SW 1/4 SE 1/4