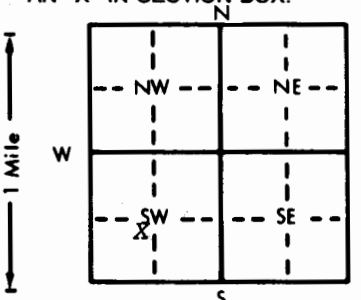


1 LOCATION OF WATER WELL: County: Wyandotte Fraction NE  $\frac{1}{4}$  SW  $\frac{1}{4}$  SW  $\frac{1}{4}$  Section Number 26 Township Number T 10 S Range Number R 25 **EW**

Distance and direction from nearest town or city street address of well if located within city?  
3101 Fairfax Trafficway, Kansas City, Kansas

2 WATER WELL OWNER: General Motors  
 RR#, St. Address, Box # : Kansas City, Kansas Board of Agriculture, Division of Water Resources  
 City, State, ZIP Code : Application Number: 37,839

3 LOCATE WELL'S LOCATION WITH AN "X" IN SECTION BOX:  

 4 DEPTH OF COMPLETED WELL: 78 ft. ELEVATION:  
 Depth(s) Groundwater Encountered 1. 16.2 ft. 2. ft. 3. ft.  
 WELL'S STATIC WATER LEVEL 16.2 ft. below land surface measured on mo/day/yr 5-16-85  
 Pump test data: Well water was ft. after hours pumping gpm  
 Est. Yield gpm: Well water was ft. after hours pumping gpm  
 Bore Hole Diameter 36 in. to 78 ft., and in. to ft.  
 WELL WATER TO BE USED AS:  
 5 Public water supply 8 Air conditioning 11 Injection well  
 1 Domestic 3 Feedlot 6 Oil field water supply **9 Dewatering** 12 Other (Specify below)  
 2 Irrigation 4 Industrial 7 Lawn and garden only 10 Observation well  
 Was a chemical/bacteriological sample submitted to Department? Yes No **X**; If yes, mo/day/yr sample was submitted  
 Water Well Disinfected? Yes No

5 TYPE OF BLANK CASING USED:  
**1 Steel** 3 RMP (SR) 5 Wrought iron 8 Concrete tile CASING JOINTS: Glued Clamped  
 2 PVC 4 ABS 6 Asbestos-Cement 9 Other (specify below) **Welded**  
 7 Fiberglass Threaded  
 Blank casing diameter 18 in. to 38 ft., Dia. in. to ft., Dia. in. to ft.  
 Casing height above land surface 24 in., weight lbs./ft. Wall thickness or gauge No.  
 TYPE OF SCREEN OR PERFORATION MATERIAL:  
**1 Steel** 3 Stainless steel 5 Fiberglass 7 PVC 10 Asbestos-cement  
 2 Brass 4 Galvanized steel 6 Concrete tile 8 RMP (SR) 11 Other (specify)  
 12 None used (open hole)  
 SCREEN OR PERFORATION OPENINGS ARE:  
 1 Continuous slot 3 Mill slot 5 Gauzed wrapped 8 Saw cut 11 None (open hole)  
 2 Louvered shutter 4 Key punched **6 Wire wrapped** 9 Drilled holes  
 7 Torch cut 10 Other (specify)  
 SCREEN-PERFORATED INTERVALS: From 78 ft. to 38 ft., From ft. to ft.  
 From ft. to ft., From ft. to ft.  
 GRAVEL PACK INTERVALS: From 78 ft. to 28 ft., From ft. to ft.  
 From ft. to ft., From ft. to ft.

6 GROUT MATERIAL: **1 Neat cement** 2 Cement grout 3 Bentonite 4 Other  
 Grout Intervals: From 0 ft. to 10 ft., From ft. to ft., From ft. to ft.  
 What is the nearest source of possible contamination:  
 1 Septic tank 4 Lateral lines 7 Pit privy 10 Livestock pens 14 Abandoned water well  
 2 Sewer lines 5 Cess pool 8 Sewage lagoon 11 Fuel storage 15 Oil well/Gas well  
 3 Watertight sewer lines 6 Seepage pit 9 Feedyard 12 Fertilizer storage 16 Other (specify below)  
 13 Insecticide storage  
 Direction from well? How many feet?

FROM	TO	LITHOLOGIC LOG	FROM	TO	LITHOLOGIC LOG
0	11'	Grey silt and clay			
11	27'	Fine to med brown sand			
27	57'	Med to coarse sand and gravel			
57	78'	Coarse sand and gravel			
78		refusal			

7 CONTRACTOR'S OR LANDOWNER'S CERTIFICATION: This water well was **1** constructed, (2) reconstructed, or (3) plugged under my jurisdiction and was completed on (mo/day/year) 5-16-85 and this record is true to the best of my knowledge and belief. Kansas Water Well Contractor's License No. 465 This Water Well Record was completed on (mo/day/yr) 7-15-85 under the business name of MORETRENCH AMERICAN CORPORATION by (signature) Joseph McElann  
 INSTRUCTIONS: Use typewriter or ball point pen, PLEASE PRESS FIRMLY and PRINT clearly. Please fill in blanks, underline or circle the correct answers. Send top three copies to Kansas Department of Health and Environment, Division of Environment, Environmental Geology Section, Topeka, KS 66620. Send one to WATER WELL OWNER and retain one for your records.

OFFICE USE ONLY

T 10

R 25

EW

SEC. 210

NE

SW

SE

SW