


1 LOCATION OF WATER WELL: County: Wyandotte Fraction NW 1/4 SW 1/4 SW 1/4 Section Number 26 Township Number T 10 S Range Number R 25 EW

Distance and direction from nearest town or city street address of well if located within city? 3101 Fairfax Trafficway, Kansas City, Kansas

2 WATER WELL OWNER: General Motors Kansas City, Kansas Board of Agriculture, Division of Water Resources Application Number: 37,882

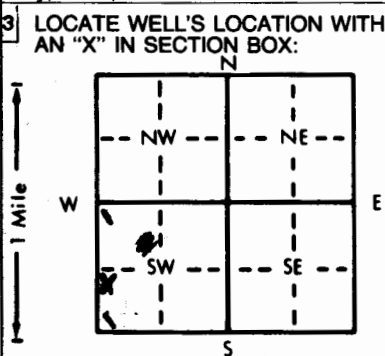

4 DEPTH OF COMPLETED WELL 90 ft. ELEVATION: Depth(s) Groundwater Encountered 1. 16.3 ft. 2. ft. 3. ft. WELL'S STATIC WATER LEVEL 16.3 ft. below land surface measured on mo/day/yr 5-31-85

5 TYPE OF BLANK CASING USED: 1 Steel 3 RMP (SR) 5 Wrought iron 8 Concrete tile CASING JOINTS: Glued Clamped Welded Threaded

Blank casing diameter 18 in. to 90 ft., Dia. Casing height above land surface 24 in., weight lbs./ft. Wall thickness or gauge No.

TYPE OF SCREEN OR PERFORATION MATERIAL: 1 Steel 3 Stainless steel 5 Fiberglass 7 PVC 10 Asbestos-cement

SCREEN OR PERFORATION OPENINGS ARE: 1 Continuous slot 3 Mill slot 5 Gauzed wrapped 8 Saw cut 11 None (open hole)

SCREEN-PERFORATED INTERVALS: From 90 ft. to 50 ft. GRAVEL PACK INTERVALS: From 90 ft. to 35 ft.

6 GROUT MATERIAL: Neat cement 2 Cement grout 3 Bentonite 4 Other Grout Intervals: From 0 ft. to 10 ft.

What is the nearest source of possible contamination: 1 Septic tank 4 Lateral lines 7 Pit privy 10 Livestock pens 14 Abandoned water well

Direction from well? How many feet? Table with columns FROM, TO, LITHOLOGIC LOG

7 CONTRACTOR'S OR LANDOWNER'S CERTIFICATION: This water well was (1) constructed (2) reconstructed, or (3) plugged under my jurisdiction and was completed on (mo/day/year) 5-31-85

INSTRUCTIONS: Use typewriter or ball point pen, PLEASE PRESS FIRMLY and PRINT clearly. Please fill in blanks, underline or circle the correct answers.