


1 LOCATION OF WATER WELL: Fraction SE 1/4 SW 1/4 NW 1/4 Section Number 26 Township Number T 10 S Range Number R 25 EW
 County: WYANDOTTE

Distance and direction from nearest town or city street address of well if located within city?
3000' North of East end of Donovan Road in Fairfax Area, Kansas City, KS

2 WATER WELL OWNER: J.A. Tobin Construction (Contractor)
 RR#, St. Address, Box #: 2100 Metro Avenue Board of Agriculture, Division of Water Resources
 City, State, ZIP Code: Kansas City, KS 66106 Application Number: 38,340

3 LOCATE WELL'S LOCATION WITH AN "X" IN SECTION BOX:

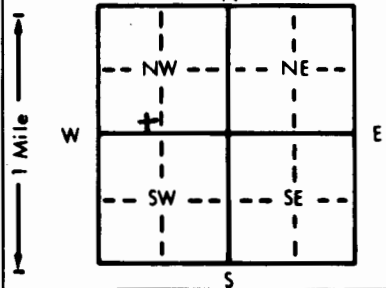

4 DEPTH OF COMPLETED WELL... 81 ft. ELEVATION:
 Depth(s) Groundwater Encountered 1. 23 ft. 2. ft. 3. ft.
 WELL'S STATIC WATER LEVEL ... 23 ft. below land surface measured on mo/day/yr ... 12/13/86
 Pump test data: Well water was ft. after hours pumping gpm
 Est. Yield 1200 gpm: Well water was ft. after hours pumping gpm
 Bore Hole Diameter... 30 in. to 81 ft., and in. to ft.
 WELL WATER TO BE USED AS: 5 Public water supply 8 Air conditioning 11 Injection well
 1 Domestic 3 Feedlot 6 Oil field water supply 9 Dewatering 12 Other (Specify below)
 2 Irrigation 4 Industrial 7 Lawn and garden only 10 Observation well
 Was a chemical/bacteriological sample submitted to Department? Yes..... No...XX...; If yes, mo/day/yr sample was submitted
 Water Well Disinfected? Yes No

5 TYPE OF BLANK CASING USED: 5 Wrought iron 8 Concrete tile CASING JOINTS: Glued XX Clamped
 1 Steel 3 RMP (SR) 6 Asbestos-Cement 9 Other (specify below) Welded
2 PVC 4 ABS 7 Fiberglass Threaded.....

Blank casing diameter ... 16 in. to 51 ft., Dia in. to ft., Dia in. to ft.
 Casing height above land surface ... 12 in., weight lbs./ft. Wall thickness or gauge No.

TYPE OF SCREEN OR PERFORATION MATERIAL: 7 PVC 10 Asbestos-cement
 1 Steel 3 Stainless steel 5 Fiberglass 8 RMP (SR) 11 Other (specify)
 2 Brass 4 Galvanized steel 6 Concrete tile 9 ABS 12 None used (open hole)

SCREEN OR PERFORATION OPENINGS ARE: 5 Gauzed wrapped 8 Saw cut 11 None (open hole)
 1 Continuous slot 3 Mill slot 6 Wire wrapped 9 Drilled holes
 2 Louvered shutter 4 Key punched 7 Torch cut 10 Other (specify)

SCREEN-PERFORATED INTERVALS: From 51 ft. to 81 ft., From ft. to ft.
 From 10 ft. to 81 ft., From ft. to ft.
 GRAVEL PACK INTERVALS: From ft. to ft., From ft. to ft.

6 GROUT MATERIAL: 1 Neat cement 2 Cement grout 3 Bentonite 4 Other
 Grout Intervals: From 0 ft. to 10 ft., From ft. to ft., From ft. to ft.

What is the nearest source of possible contamination: Missouri River
 1 Septic tank 4 Lateral lines 7 Pit privy 11 Fuel storage 14 Abandoned water well
 2 Sewer lines 5 Cess pool 8 Sewage lagoon 12 Fertilizer storage 15 Oil well/Gas well
 3 Watertight sewer lines 6 Seepage pit 9 Feedyard 13 Insecticide storage
 6 Other (specify below) Missouri River

Direction from well? EAST How many feet? 1800'

FROM	TO	LITHOLOGIC LOG	FROM	TO	LITHOLOGIC LOG
0	3	Topsoil			
3	15	Fine Sand			
15	31	Fine Sand			
31	50	Medium Sand - Trace Gravel			
50	60	Medium Sand - Good			
60	70	M-C Sand & Gravel			
70	80	Coarse sand and Gravel			
80	81	Boulders			

7 CONTRACTOR'S OR LANDOWNER'S CERTIFICATION: This water well was (1) constructed, (2) reconstructed, or (3) plugged under my jurisdiction and was completed on (mo/day/year) 12/13/86 and this record is true to the best of my knowledge and belief. Kansas Water Well Contractor's License No. 429 This Water Well Record was completed on (mo/day/yr) 5/4/88 under the business name of Stacon Construction Corporation by (signature) [Signature]

INSTRUCTIONS: Use typewriter or ball point pen. PLEASE PRESS FIRMLY and PRINT clearly. Please fill in blanks, underline or circle the correct answers. Send top three copies to Kansas Department of Health and Environment, Bureau of Water Protection, Topeka, Kansas 66620-7320, Telephone: 913-862-9360. Send one to WATER WELL OWNER and retain one for your records.