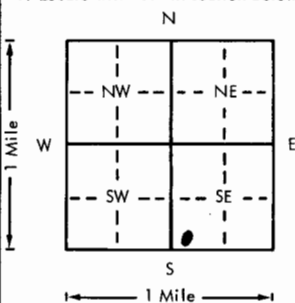
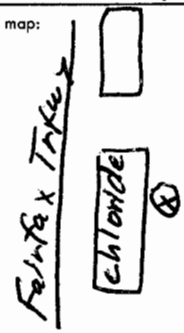


USE TYPEWRITER OR BALL POINT PEN—PRESS FIRMLY, PRINT CLEARLY.

WATER WELL RECORD
KSA 82a-1201-1215

Kansas Department of Health and Environment—Division of Environment (Water well Contractors) Topeka, Kansas 66620

1. Location of well:	County: <u>Wyandotte</u>	Fraction: <u>SW 1/4 SW 1/4 SE 1/4</u>	Section number: <u>27</u>	Township number: <u>T 10 S R 25 E</u>	Range number: <u>25 E</u>
2. Distance and direction from nearest town or city: Street address of well location if in city: <u>3001 Fairfax Trfwy</u>			3. Owner of well: <u>Chlowde Industrial Baff</u> R.R. or street: <u>3001 Fairfax Trafficway</u> City, state, zip code: <u>Kansas City, Kansas</u>		
4. Locate with "X" in section below: 			Sketch map: 		
5. Type and color of material			From	To	6. Bore hole dia. <u>12</u> in. Completion date <u>8-7-81</u> Well depth <u>91</u> ft.
<u>Top Soil & Fill</u>			<u>0</u>	<u>12</u>	7. <input checked="" type="checkbox"/> Cable tool <input checked="" type="checkbox"/> Rotary <input type="checkbox"/> Driven <input type="checkbox"/> Dug <input type="checkbox"/> Hollow rod <input type="checkbox"/> Jetted <input type="checkbox"/> Bored <input type="checkbox"/> Reverse rotary
<u>Fine Sand</u>			<u>12</u>	<u>31</u>	8. Use: <input type="checkbox"/> Domestic <input type="checkbox"/> Public supply <input checked="" type="checkbox"/> Industry <input type="checkbox"/> Irrigation <input type="checkbox"/> Air conditioning <input type="checkbox"/> Stock <input type="checkbox"/> Lawn <input type="checkbox"/> Oil field water <input type="checkbox"/> Other
<u>Sand & Fine Gravel</u>			<u>31</u>	<u>47</u>	9. Casing: Material _____ Height: Above or below Threaded _____ Welded <input checked="" type="checkbox"/> Surface <u>12</u> in. RMP _____ PVC <input checked="" type="checkbox"/> Weight <u>5,808</u> lbs./ft. Dia. <u>8</u> in. to <u>80</u> ft. depth Wall Thickness: inches or Dia. _____ in. to _____ ft. depth gage No. <u>332</u>
<u>Sand & Medium Gravel</u>			<u>47</u>	<u>51</u>	10. Screen: Manufacturer's name <u>Johnson</u> Type <u>Galv</u> Dia. <u>8</u> Slot/gauze <u>.045</u> Length <u>7'</u> Set between <u>80</u> ft. and <u>87</u> ft. _____ ft. and _____ ft. Gravel pack? <u>Yes</u> Size range of material <u>1/4 x 1/8</u>
<u>Blue Mud Sand & Gravel</u>			<u>51</u>	<u>56</u>	11. Static water level: _____ mo./day/yr. <u>24</u> ft. below land surface Date <u>8/7/81</u>
<u>Course Sand and Pea Gravel</u>			<u>56</u>	<u>91</u>	12. Pumping level below land surfaces: <u>29</u> ft. after <u>1</u> hrs. pumping <u>135</u> g.p.m. _____ ft. after _____ hrs. pumping _____ g.p.m. Estimated maximum yield <u>250</u> g.p.m.
					13. Water sample submitted: _____ mo./day/yr. <input type="checkbox"/> Yes <input checked="" type="checkbox"/> No Date _____
					14. Well head completion: <input type="checkbox"/> Pitless adapter <u>12</u> Inches above grade
					15. Well grouted? _____ With: _____ Neat cement <input checked="" type="checkbox"/> Bentonite _____ Concrete Depth: From <u>15</u> ft. to <u>0</u> ft.
					16. Nearest source of possible contamination: ft. <u>3000'</u> Direction <u>East</u> Type <u>River</u> Well disinfected upon completion? <input checked="" type="checkbox"/> Yes <input type="checkbox"/> No
					17. Pump: _____ Not installed Manufacturer's name <u>Jaccuzi</u> Model number _____ HP <u>10</u> Volts <u>230</u> Length of drop pipe <u>84</u> ft. capacity <u>140</u> g.p.m. Type: <u>120 @ 80'</u> <input checked="" type="checkbox"/> Submersible _____ Turbine <input type="checkbox"/> Jet _____ Reciprocating <input type="checkbox"/> Centrifugal _____ Other
18. Elevation: <u>740'</u> Topography: _____ Hill _____ Slope <input checked="" type="checkbox"/> Upland <input checked="" type="checkbox"/> Valley			19. Remarks: Customer is aware of state regulation and agrees to install a 4' square re-enforced concrete platform around top of well.		
			20. Water well contractor's certification: This well was drilled under my jurisdiction and this report is true to the best of my knowledge and belief. Business name <u>F.E. Young Drilling</u> License No. <u>240</u> Address <u>6355 Robin Hood Meridian</u> Signed <u>David Young</u> Date <u>9-4-81</u> Authorized representative		

T 10 S R 25 E W 27 S W 1/4 1/4 1/4