


1 LOCATION OF WATER WELL: County: <b>Wyandotte</b>	Fraction <b>NE 1/4 SE 1/4 NE 1/4</b>	Section Number <b>27</b>	Township Number <b>T 10 S</b>	Range Number <b>R 25 EW</b>
---	---	-----------------------------	----------------------------------	--------------------------------

Distance and direction from nearest town or city street address of well if located within city?  
**3250' NE of 3101 Fairfax Trafficway, Kansas City, Kansas**

2 WATER WELL OWNER: **General Motors Corporation**  
 RR#, St. Address, Box #: **100 Kindelberger Road**  
 City, State, ZIP Code: **Kansas City, Kansas**  
 Board of Agriculture, Division of Water Resources  
 Application Number:

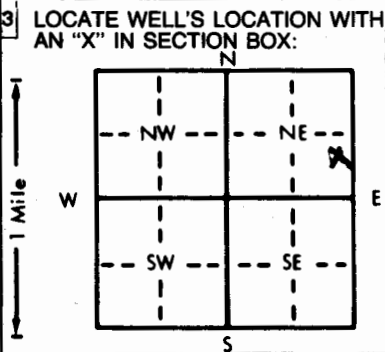

4 DEPTH OF COMPLETED WELL: **35.0** ft. ELEVATION: **741.7 (g.s.)**

Depth(s) Groundwater Encountered 1. .... ft. 2. .... ft. 3. .... ft.

WELL'S STATIC WATER LEVEL .... ft. below land surface measured on mo/day/yr

Pump test data: Well water was .... ft. after .... hours pumping .... gpm

Est. Yield .... gpm: Well water was .... ft. after .... hours pumping .... gpm

Bore Hole Diameter .... **6** in. to **35.0** ft., and .... in. to .... ft.

WELL WATER TO BE USED AS:

5 Public water supply	8 Air conditioning	11 Injection well
1 Domestic	3 Feedlot	6 Oil field water supply
2 Irrigation	4 Industrial	7 Lawn and garden only
		<b>10 Observation well</b>
		<b>Monitoring</b>

Was a chemical/bacteriological sample submitted to Department? Yes.....No. **X**.....; If yes, mo/day/yr sample was submitted

Water Well Disinfected? Yes No **X**

5 TYPE OF BLANK CASING USED:

1 Steel	3 RMP (SR)	6 Asbestos-Cement	9 Other (specify below)
<b>2 PVC</b>	4 ABS	7 Fiberglass	

Blank casing diameter .... **2** in. to **15.0** ft., Dia. .... in. to .... ft., Dia. .... in. to .... ft.

Casing height above land surface .... **24** in., weight .... lbs./ft. Wall thickness or gauge No. **Sched. 40**

TYPE OF SCREEN OR PERFORATION MATERIAL:

1 Steel	3 Stainless steel	5 Fiberglass	<b>7 PVC</b>	10 Asbestos-cement
2 Brass	4 Galvanized steel	6 Concrete tile	8 RMP (SR)	11 Other (specify)
			9 ABS	12 None used (open hole)

SCREEN OR PERFORATION OPENINGS ARE:

1 Continuous slot	<b>3 Mill slot</b>	5 Gauzed wrapped	8 Saw cut	11 None (open hole)
2 Louvered shutter	4 Key punched	6 Wire wrapped	9 Drilled holes	
		7 Torch cut	10 Other (specify)	

SCREEN-PERFORATED INTERVALS: From .... **15.0** ft. to **35.0** ft., From .... ft. to .... ft.

GRAVEL PACK INTERVALS: From .... **13.0** ft. to **35.0** ft., From .... ft. to .... ft.

6 GROUT MATERIAL: 1 Neat cement **2 Cement grout** **3 Bentonite pellets** 4 Other

Grout Intervals: From .... **0.0** ft. to **11.0** ft., From **11.0** ft. to **13.0** ft., From .... ft. to .... ft.

What is the nearest source of possible contamination:

1 Septic tank	4 Lateral lines	7 Pit privy	<b>11 Fuel storage</b>	14 Abandoned water well
2 Sewer lines	5 Cess pool	8 Sewage lagoon	12 Fertilizer storage	15 Oil well/Gas well
3 Watertight sewer lines	6 Seepage pit	9 Feedyard	13 Insecticide storage	16 Other (specify below)

Direction from well? **SW** How many feet? **3050'**

FROM	TO	LITHOLOGIC LOG	FROM	TO	LITHOLOGIC LOG
0.0	2.0	Topsoil			
2.0	6.0	Silty clay			
6.0	12.0	Sandy silt			
12.0	21.0	Fine sand			
21.0	35.0	Coarse sand			
35.0	Total	depth			

7 CONTRACTOR'S OR LANDOWNER'S CERTIFICATION: This water well was **(1)** constructed, (2) reconstructed, or (3) plugged under my jurisdiction and was completed on (mo/day/year) **4/15/85** and this record is true to the best of my knowledge and belief. Kansas Water Well Contractor's License No. **102** This Water Well Record was completed on (mo/day/yr) **6/15/85** under the business name of **Layne-Western Company, Inc.** by (signature) *Diana J. Alumbaugh*

INSTRUCTIONS: Use typewriter or ball point pen, PLEASE PRESS FIRMLY and PRINT clearly. Please fill in blanks, underline or circle the correct answers. Send top three copies to Kansas Department of Health and Environment, Division of Environment, Environmental Geology Section, Topeka, KS 66620. Send one to WATER WELL OWNER and retain one for your records.