


1 LOCATION OF WATER WELL: Fraction SW 1/4 NE 1/4 SE 1/4 Section Number 27 Township Number T 10 S Range Number R 25 E
 County: Wyandotte

Distance and direction from nearest town or city street address of well if located within city?
1300' NE of Fairfax Trafficway - KC, Ks.

2 WATER WELL OWNER: General Motors Corp.
 RR#, St. Address, Box # : 100 Kindelberger Road Board of Agriculture, Division of Water Resources
 City, State, ZIP Code : KC Ks. 66115 Application Number:

3 LOCATE WELL'S LOCATION WITH AN "X" IN SECTION BOX:

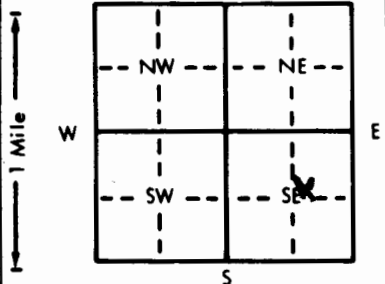

4 DEPTH OF COMPLETED WELL: 113.0 ft. ELEVATION:
 Depth(s) Groundwater Encountered 1. top of casing ft. 2. top of casing ft. 3. top of casing ft.
 WELL'S STATIC WATER LEVEL top of casing ft. below land surface measured on mo/day/yr
 Pump test data: Well water was ft. after hours pumping gpm
 Est. Yield gpm: Well water was ft. after hours pumping gpm
 Bore Hole Diameter 6 in. to 113.0 ft., and in. to ft.
 WELL WATER TO BE USED AS: 5 Public water supply 8 Air conditioning 11 Injection well
 1 Domestic 3 Feedlot 6 Oil field water supply 9 Dewatering 12 Other (Specify below)
 2 Irrigation 4 Industrial 7 Lawn and garden only 10 Observation well Monitoring
 Was a chemical/bacteriological sample submitted to Department? Yes No X; If yes, mo/day/yr sample was submitted
 Water Well Disinfected? Yes No X

5 TYPE OF BLANK CASING USED: 5 Wrought iron 8 Concrete tile CASING JOINTS: Glued Clamped
 1 Steel 3 RMP (SR) 6 Asbestos-Cement 9 Other (specify below) Welded
2 VC 4 ABS 7 Fiberglass Threaded X
 Blank casing diameter 2 in. to 88 ft., Dia 2" ~~XXX~~ 108 to 113 ft., Dia in. to ft.
 Casing height above land surface 24 in., weight lbs./ft. Wall thickness or gauge No. Schedule 40

TYPE OF SCREEN OR PERFORATION MATERIAL: 7 PVC 10 Asbestos-cement
 1 Steel 3 Stainless steel 5 Fiberglass 8 RMP (SR) 11 Other (specify)
 2 Brass 4 Galvanized steel 6 Concrete tile 9 ABS 12 None used (open hole)

SCREEN OR PERFORATION OPENINGS ARE: 5 Gauzed wrapped 8 Saw cut 11 None (open hole)
 1 Continuous slot 3 Mill slot 6 Wire wrapped 9 Drilled holes
 2 Louvered shutter 4 Key punched 7 Torch cut 10 Other (specify)

SCREEN-PERFORATED INTERVALS: From 88.0 ft. to 108.0 ft., From ft. to ft.
 From ft. to ft., From ft. to ft.
 GRAVEL PACK INTERVALS: From 85.0 ft. to 113.0 ft., From ft. to ft.
 From ft. to ft., From ft. to ft.

6 GROUT MATERIAL: 1 Neat cement 2 Cement grout 3 Bentonite pellets 4 Other
 Grout Intervals: From 0.0 ft. to 83.0 ft., From 83.0 ft. to 85.0 ft., From ft. to ft.

What is the nearest source of possible contamination:
 1 Septic tank 4 Lateral lines 7 Pit privy 11 Fuel storage 14 Abandoned water well
 2 Sewer lines 5 Cess pool 8 Sewage lagoon 12 Fertilizer storage 15 Oil well/Gas well
 3 Watertight sewer lines 6 Seepage pit 9 Feedyard 13 Insecticide storage 16 Other (specify below)
 Direction from well? SW How many feet? 1100

FROM	TO	LITHOLOGIC LOG	FROM	TO	LITHOLOGIC LOG
0.0	2.0	Topsoil			
2.0	4.0	Clayey silt			
4.0	6.0	Sandy silt			
6.0	26.0	Fine sand			
26.0	38.5	Medium to coarse sand			
38.5	48.5	Fine sand			
48.5	60.0	Medium to coarse sand, gravel & clay			
60.0	70.0	Medium to coarse sand, gravel			
70.0	100.0	Same with boulders			
100.0	107.0	Same			
107.0	113.0	Gray shale			
113.0	Total	Depth			

7 CONTRACTOR'S OR LANDOWNER'S CERTIFICATION: This water well was (1) constructed, (2) reconstructed, or (3) plugged under my jurisdiction and was completed on (mo/day/year) 4/11/85 and this record is true to the best of my knowledge and belief. Kansas Water Well Contractor's License No. 102 This Water Well Record was completed on (mo/day/yr) 6/15/85
 under the business name of Layne-Western Company, Inc. by (signature) Diana Deumbaugh

INSTRUCTIONS: Use typewriter or ball point pen, PLEASE PRESS FIRMLY and PRINT clearly. Please fill in blanks, underline or circle the correct answers. Send top three copies to Kansas Department of Health and Environment, Division of Environment, Environmental Geology Section, Topeka, KS 66620. Send one to WATER WELL OWNER and retain one for your records.