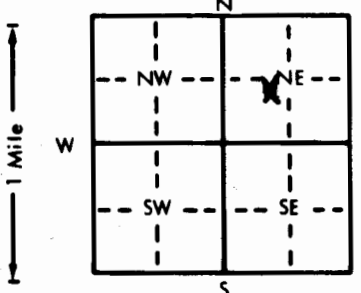


1 LOCATION OF WATER WELL: County: Wyandotte	Fraction NE 1/4 SW 1/4 NE 1/4	Section Number 27	Township Number T 10 S	Range Number R 25 E/W
---	---	-----------------------------	----------------------------------	--

Distance and direction from nearest town or city street address of well if located within city?
3300' North of 3101 Fairfax Trafficway - KC, Ks.

2 WATER WELL OWNER: **General Motors Corp.**
 RR#, St. Address, Box #: **100 Kindelberger Road**
 City, State, ZIP Code: **KC, Ks. 66115**
 Board of Agriculture, Division of Water Resources
 Application Number:

3 LOCATE WELL'S LOCATION WITH AN "X" IN SECTION BOX:

 4 DEPTH OF COMPLETED WELL: **35'** ft. ELEVATION: **743.6** (g.s.)
 Depth(s) Groundwater Encountered 1. ft. 2. ft. 3. ft.
 WELL'S STATIC WATER LEVEL: **27.2** ft. below ^{top of casing} land surface measured on mo/day/yr **3/28/85**
 Pump test data: Well water was ft. after hours pumping gpm
 Est. Yield gpm: Well water was ft. after hours pumping gpm
 Bore Hole Diameter: **.6** in. to **35'** ft., and in. to ft.
 WELL WATER TO BE USED AS:
 1 Domestic 3 Feedlot 6 Oil field water supply 9 Dewatering Other (Specify below)
 2 Irrigation 4 Industrial 7 Lawn and garden only **Observation well** **Monitoring**
 Was a chemical/bacteriological sample submitted to Department? Yes.....No.....**X**.....; If yes, mo/day/yr sample was submitted
 Water Well Disinfected? Yes.....No.....**X**.....

5 TYPE OF BLANK CASING USED:
 1 Steel 3 RMP (SR) 5 Wrought iron 8 Concrete tile CASING JOINTS: Glued.....Clamped.....
 2 PVC 4 ABS 6 Asbestos-Cement 9 Other (specify below) Welded.....
 7 Fiberglass Threaded.....**X**.....
 Blank casing diameter **2** in. to **15** ft., Dia in. to ft., Dia in. to ft.
 Casing height above land surface **24** in., weight lbs./ft. Wall thickness or gauge No. **Schedule 40**
 TYPE OF SCREEN OR PERFORATION MATERIAL:
 7 PVC 10 Asbestos-cement
 1 Steel 3 Stainless steel 5 Fiberglass 8 RMP (SR) 11 Other (specify)
 2 Brass 4 Galvanized steel 6 Concrete tile 9 ABS 12 None used (open hole)
 SCREEN OR PERFORATION OPENINGS ARE:
 1 Continuous slot 3 Mill slot 5 Gauzed wrapped 8 Saw cut 11 None (open hole)
 2 Louvered shutter 4 Key punched 6 Wire wrapped 9 Drilled holes
 7 Torch cut 10 Other (specify)
 SCREEN-PERFORATED INTERVALS: From **15.0** ft. to **35.0** ft., From ft. to ft.
 From ft. to ft., From ft. to ft.
 GRAVEL PACK INTERVALS: From **13.0** ft. to **35.0** ft., From ft. to ft.
 From ft. to ft., From ft. to ft.

6 GROUT MATERIAL: 1 Neat cement 2 Cement grout 3 Bentonite pellets 4 Other
 Grout Intervals: From... **0.0** ft. to **11.0** ft., From **11.0** ft. to **13.0** ft., From ft. to ft.
 What is the nearest source of possible contamination:
 1 Septic tank 4 Lateral lines 7 Pit privy 10 Livestock pens 14 Abandoned water well
 2 Sewer lines 5 Cess pool 8 Sewage lagoon 11 Fuel storage 15 Oil well/Gas well
 3 Watertight sewer lines 6 Seepage pit 9 Feedyard 12 Fertilizer storage 16 Other (specify below)
 13 Insecticide storage
 Direction from well? **South** How many feet? **3000'**

FROM	TO	LITHOLOGIC LOG	FROM	TO	LITHOLOGIC LOG
0.0	0.4	Concrete			
0.4	1.0	Crushed rock & clay, medium			
1.0	8.5	Gray & brown silty clay, medium			
8.5	13.0	Gray-brown sandy silt, medium			
13.0	16.0	Brown sandy silt, medium			
16.0	25.0	Brown very fine sand, moist, dense			
25.0	28.5	Brown medium to coarse sand, dense			
28.5	35.0	Gray-brown medium to coarse sand, dense			
35.0	Total	Depth			

7 CONTRACTOR'S OR LANDOWNER'S CERTIFICATION: This water well was (1) constructed, (2) reconstructed, or (3) plugged under my jurisdiction and was completed on (mo/day/year) **3/27/85** and this record is true to the best of my knowledge and belief. Kansas Water Well Contractor's License No. **102** This Water Well Record was completed on (mo/day/yr) **6/15/85** under the business name of **Layne-Western Company, Inc.** by (signature) **Dianna L. Alumbaugh**

INSTRUCTIONS: Use typewriter or ball point pen, PLEASE PRESS FIRMLY and PRINT clearly. Please fill in blanks, underline or circle the correct answers. Send top three copies to Kansas Department of Health and Environment, Division of Environment, Environmental Geology Section, Topeka, KS 66620. Send one to WATER WELL OWNER and retain one for your records.