


1 LOCATION OF WATER WELL: County: Wyandotte	Fraction NE 1/4 SW 1/4 NE 1/4	Section Number 27	Township Number T 10 S	Range Number R 25 E W
--	----------------------------------	----------------------	---------------------------	---------------------------------

Distance and direction from nearest town or city street address of well if located within city?
 3300' North of 3101 Fairfax Trafficway - KC, Ks.

2 WATER WELL OWNER: General Motors Corp.
 RR#, St. Address, Box # : 100 Kindelberger Road
 City, State, ZIP Code : KC, Ks. 66115
 Board of Agriculture, Division of Water Resources
 Application Number:

3 LOCATE WELL'S LOCATION WITH AN "X" IN SECTION BOX:

4 DEPTH OF COMPLETED WELL: 85.0' ft. ELEVATION: 743.6 (g.s.)

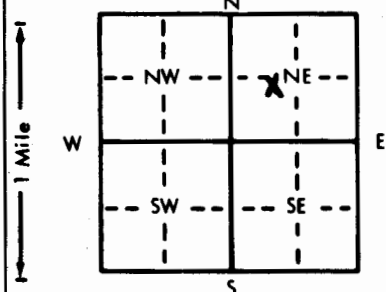

Depth(s) Groundwater Encountered 1. ft. 2. ft. 3. ft.
 WELL'S STATIC WATER LEVEL 28.4 ft. below top of casing measured on mo/day/yr 3/29/85
 Pump test data: Well water was . ft. after . hours pumping . gpm
 Est. Yield . gpm: Well water was . ft. after . hours pumping . gpm
 Bore Hole Diameter . 6 in. to 85.0 ft., and . in. to . ft.
 WELL WATER TO BE USED AS:
 1 Domestic 3 Feedlot 6 Oil field water supply 9 Dewatering 11 Injection well
 2 Irrigation 4 Industrial 7 Lawn and garden only 10 Observation well 12 Other (Specify below) **Monitoring**
 Was a chemical/bacteriological sample submitted to Department? Yes . No **X** .; If yes, mo/day/yr sample was submitted . Water Well Disinfected? Yes . No **X**

5 TYPE OF BLANK CASING USED:
 1 Steel 3 RMP (SR) 5 Wrought iron 8 Concrete tile CASING JOINTS: Glued . Clamped .
 2 **PVC** 4 ABS 6 Asbestos-Cement 9 Other (specify below) Welded .
 7 Fiberglass Threaded . **X**

Blank casing diameter . 2 in. to 65.0 ft., Dia . in. to . ft., Dia . in. to . ft.
 Casing height above land surface . 24 in., weight . lbs./ft. Wall thickness or gauge No. Schedule 40 .

TYPE OF SCREEN OR PERFORATION MATERIAL:
 1 Steel 3 Stainless steel 5 Fiberglass 7 **PVC** 10 Asbestos-cement
 2 Brass 4 Galvanized steel 6 Concrete tile 8 RMP (SR) 11 Other (specify) .
 12 None used (open hole)

SCREEN OR PERFORATION OPENINGS ARE:
 1 Continuous slot 3 Mill slot 5 Gauzed wrapped 8 Saw cut 11 None (open hole)
 2 Louvered shutter 4 Key punched 6 Wire wrapped 9 Drilled holes
 7 Torch cut 10 Other (specify) .

SCREEN-PERFORATED INTERVALS: From . 65.0 ft. to . 85.0 ft., From . ft. to . ft.
 GRAVEL PACK INTERVALS: From . 63.0 ft. to . 85.0 ft., From . ft. to . ft.

6 GROUT MATERIAL: 1 Neat cement 2 **Cement grout** 3 **Bentonite pellets** 4 Other .
 Grout Intervals: From . 0.0 ft. to . 61.0 ft., From . 61.0 ft. to . 63.0 ft., From . ft. to . ft.

What is the nearest source of possible contamination:
 1 Septic tank 4 Lateral lines 7 Pit privy 10 Livestock pens 14 Abandoned water well
 2 Sewer lines 5 Cess pool 8 Sewage lagoon 11 Fuel storage 15 Oil well/Gas well
 3 Watertight sewer lines 6 Seepage pit 9 Feedyard 12 Fertilizer storage 16 Other (specify below)
 13 Insecticide storage

Direction from well? South How many feet? 3000'

FROM	TO	LITHOLOGIC LOG	FROM	TO	LITHOLOGIC LOG
0.0	0.5	Concrete			
0.5	1.0	Crushed rock & clay			
1.0	11.0	Dark gray silty clay, medium			
11.0	13.5	Brown sandy silt, medium			
13.5	31.0	Brown fine sand, dense			
31.0	85.0	Brown coarse to medium sand & gravel few boulders			
85.0	Total	Depth			

7 CONTRACTOR'S OR LANDOWNER'S CERTIFICATION: This water well was (1) constructed, (2) reconstructed, or (3) plugged under my jurisdiction and was completed on (mo/day/year) . 3/27/85 . and this record is true to the best of my knowledge and belief. Kansas Water Well Contractor's License No. . 102 . This Water Well Record was completed on (mo/day/yr) . 6/15/85 . under the business name of Layne-Western Company, Inc. by (signature) Diana J. Alumbaugh

INSTRUCTIONS: Use typewriter or ball point pen, PLEASE PRESS FIRMLY and PRINT clearly. Please fill in blanks, underline or circle the correct answers. Send top three copies to Kansas Department of Health and Environment, Division of Environment, Environmental Geology Section, Topeka, KS 66620. Send one to WATER WELL OWNER and retain one for your records.