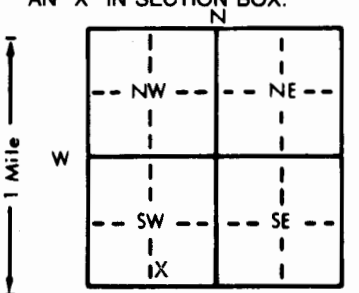


1 LOCATION OF WATER WELL: Fraction SW 1/4 Section Number 27 Township Number T 10 S Range Number R 25 **EW**
 County: Wyandotte

Distance and direction from nearest town or city street address of well if located within city?
3111 Fiberglass Road, Kansas City, Kansas

2 WATER WELL OWNER: Republic Paperboard Company
 RR#, St. Address, Box # : 3111 Fiberglass Road Board of Agriculture, Division of Water Resources
 City, State, ZIP Code : Kansas City, Kansas 66115 Application Number: NA

3 LOCATE WELL'S LOCATION WITH AN "X" IN SECTION BOX:

 4 DEPTH OF COMPLETED WELL: 28 ft. ELEVATION: about 747
 Depth(s) Groundwater Encountered 1. 16' 7" ft. 2. _____ ft. 3. _____ ft.
 WELL'S STATIC WATER LEVEL 16' 7" ft. below land surface measured on mo/day/yr 8-31-90
 Pump test data: Well water was _____ ft. after _____ hours pumping _____ gpm
 Est. Yield 3 gpm: Well water was _____ ft. after _____ hours pumping _____ gpm
 Bore Hole Diameter 8.63 in. to 28 ft., and _____ in. to _____ ft.
 WELL WATER TO BE USED AS: 5 Public water supply 8 Air conditioning 11 Injection well
 1 Domestic 3 Feedlot 6 Oil field water supply 9 Dewatering 12 Other (Specify below)
 2 Irrigation 4 Industrial 7 Lawn and garden only 10 Observation well monitoring
 Was a chemical bacteriological sample submitted to Department? Yes XX No _____; If yes, mo/day/yr sample was submitted Attached - private lab Water Well Disinfected? Yes _____ No _____

5 TYPE OF BLANK CASING USED:
 1 Steel 3 RMP (SR) 5 Wrought iron 8 Concrete tile CASING JOINTS: Glued _____ Clamped _____
2 PVC 4 ABS 6 Asbestos-Cement 9 Other (specify below) Welded _____
 7 Fiberglass Threaded _____
 Blank casing diameter 2.375 in. to 8 ft., Dia _____ in. to _____ ft., Dia _____ in. to _____ ft.
 Casing height above land surface 24 in., weight 0.70 lbs./ft. Wall thickness or gauge No. 0.154 inches
 TYPE OF SCREEN OR PERFORATION MATERIAL:
 1 Steel 3 Stainless steel ~~XXXXXX~~ Fiberglass 7 PVC 10 Asbestos-cement
 2 Brass 4 Galvanized steel 6 Concrete tile 9 ABS 11 Other (specify) _____
 12 None used (open hole)
 SCREEN OR PERFORATION OPENINGS ARE:
 1 Continuous slot 3 Mill slot 0.01" slot 5 Gauzed wrapped 8 Saw cut 11 None (open hole)
 2 Louvered shutter 4 Key punched 6 Wire wrapped 9 Drilled holes
 7 Torch cut 10 Other (specify) _____
 SCREEN-PERFORATED INTERVALS: From 8 ft. to 28 ft., From _____ ft. to _____ ft.
 From _____ ft. to _____ ft., From _____ ft. to _____ ft.
 GRAVEL PACK INTERVALS: From 28 ft. to 6 ft., From _____ ft. to _____ ft.
0.0234 - 0.0469" From _____ ft. to _____ ft., From _____ ft. to _____ ft.

6 GROUT MATERIAL: 1 Neat cement 2 Cement grout 3 Bentonite 4 Other 1/4" pellets bentonite
 Grout intervals: From (#4) 6 ft. to 4 ft., From (#3) 4 ft. to 0 ft., From _____ ft. to _____ ft.
 What is the nearest source of possible contamination:
 1 Septic tank 4 Lateral lines 7 Pit privy 11 Fuel storage 14 Abandoned water well
 2 Sewer lines 5 Cess pool 8 Sewage lagoon 12 Fertilizer storage 15 Oil well/Gas well
 3 Watertight sewer lines 6 Seepage pit 9 Feedyard 13 Insecticide storage 16 Other (specify below)
 Direction from well? West How many feet? 15 feet

FROM	TO	LITHOLOGIC LOG	FROM	TO	LITHOLOGIC LOG
0	1	asphalt and AB-3 sub-base rock			
1	10	clay, silty, moist, dark brown to brownish gray (alluvial sediments of Missouri River Flood plain)			
10	15	silt with clay, moist, brownish gray, some sand (alluvial deposits)			
15	28	very fine to fine sand whitish brown to gray saturated at 16' 7" B.G.L. (alluvial sands of Missouri River Flood plain)			

7 CONTRACTOR'S OR LANDOWNER'S CERTIFICATION: This water well was (1) constructed (2) reconstructed, or (3) plugged under my jurisdiction and was completed on (mo/day/year) August 31, 1990 and this record is true to the best of my knowledge and belief. Kansas Water Well Contractor's License No. 483 This Water Well Record was completed on (mo/day/yr) September 25, 1990 under the business name of Total Environmental Services/Technologies by (signature) Dwight Brinkley

INSTRUCTIONS: Use typewriter or ball point pen. PLEASE PRESS FIRMLY and PRINT clearly. Please fill in blanks, underline or circle the correct answers. Send top three copies to Kansas Department of Health and Environment, Bureau of Water Protection, Topeka, Kansas 66620-7320, Telephone: 913-862-9360. Send one to WATER WELL OWNER and retain one for your records.

OFFICE USE ONLY
T
R
EW
SEC.