


1] LOCATION OF WATER WELL: County: Wyandotte	Fraction NW 1/4 NW 1/4 SW 1/4	Section Number 28	Township Number T 10 S	Range Number R 25	<b>EW</b>
---	----------------------------------	----------------------	---------------------------	----------------------	-----------

Distance and direction from nearest town or city street address of well if located within city?  
approx. 250' E & 50' S of the SE corner of the Quindaro Plant Offices

2] WATER WELL OWNER: Board of Public Utilities  
RR#, St. Address, Box #: 3601 N. 12th Street  
City, State, ZIP Code: Kansas City, Kansas 66104  
Board of Agriculture, Division of Water Resources  
Application Number:

3] LOCATE WELL'S LOCATION WITH AN "X" IN SECTION BOX:

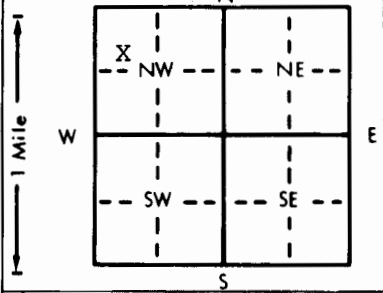

4] DEPTH OF COMPLETED WELL: 30.0 ft. ELEVATION: 724.2

Depth(s) Groundwater Encountered 1. ft. 2. ft. 3. ft.

WELL'S STATIC WATER LEVEL: 20.6 ft. below land surface measured on mo/day/yr 9/28/84

Pump test data: Well water was ft. after hours pumping gpm

Est. Yield gpm: Well water was ft. after hours pumping gpm

Bore Hole Diameter: 8" in. to 32.5' ft., and in. to ft.

WELL WATER TO BE USED AS:

5 Public water supply	8 Air conditioning	11 Injection well
1 Domestic	3 Feedlot	6 Oil field water supply
2 Irrigation	4 Industrial	7 Lawn and garden only
		9 Dewatering
		10 Observation well
		12 Other (Specify below) <b>Monitoring</b>

Was a chemical/bacteriological sample submitted to Department? Yes No **X**; If yes, mo/day/yr sample was submitted

Water Well Disinfected? Yes No **X**

5] TYPE OF BLANK CASING USED:

1 Steel	3 RMP (SR)	5 Wrought iron	8 Concrete tile	CASING JOINTS: Glued <b>X</b> Clamped
<b>2 PVC</b>	4 ABS	6 Asbestos-Cement	9 Other (specify below)	Welded
		7 Fiberglass		Threaded

Blank casing diameter 4 in. to ft., Dia in. to ft., Dia in. to ft.

Casing height above land surface 24 in., weight lbs./ft. Wall thickness or gauge No. Schedule 40

TYPE OF SCREEN OR PERFORATION MATERIAL:

1 Steel	3 Stainless steel	5 Fiberglass	<b>7 PVC</b>	10 Asbestos-cement
2 Brass	4 Galvanized steel	6 Concrete tile	8 RMP (SR)	11 Other (specify)
			9 ABS	12 None used (open hole)

SCREEN OR PERFORATION OPENINGS ARE:

1 Continuous slot	3 Mill slot	5 Gauzed wrapped	<b>8 Saw cut</b>	11 None (open hole)
2 Louvered shutter	4 Key punched	6 Wire wrapped	9 Drilled holes	
		7 Torch cut	10 Other (specify)	

SCREEN-PERFORATED INTERVALS: From 5.0 ft. to 30.1 ft., From ft. to ft.

GRAVEL PACK INTERVALS: From 5.0 ft. to 30.1 ft., From ft. to ft.

6] GROUT MATERIAL: 1 Neat cement **2 Cement grout** **3 Bentonite pellets** 4 Other

Grout Intervals: From 4.0 ft. to 0.0 ft., From 4.0 ft. to 5.0 ft., From ft. to ft.

What is the nearest source of possible contamination:

1 Septic tank	4 Lateral lines	7 Pit privy	10 Livestock pens	14 Abandoned water well
2 Sewer lines	5 Cess pool	8 Sewage lagoon	11 Fuel storage	15 Oil well/Gas well
3 Watertight sewer lines	6 Seepage pit	9 Feedyard	12 Fertilizer storage	<b>16 Other (specify below) oil supply pipeline</b>
			13 Insecticide storage	

Direction from well? S & W How many feet? 10

FROM	TO	LITHOLOGIC LOG	FROM	TO	LITHOLOGIC LOG
0.0	1.0	Dark brown SILTY CLAY with concrete, moist, stiff (FILL)			
1.0	5.5	Dark brown silty clay, moist, very stiff			
5.5	8.0	Gray & brown silty clay, trace sand, moist, stiff			
8.0	11.0	Gray & brown silty clay, moist, stiff			
11.0	20.0	Brown silty clay with trace sand, moist, stiff			
20.0	31.0	Brown fine sandy silt, moist, stiff			
31.0	TD				

7] CONTRACTOR'S OR LANDOWNER'S CERTIFICATION: This water well was **1** constructed, **2** reconstructed, or **3** plugged under my jurisdiction and was completed on (mo/day/year) 10/2/84 and this record is true to the best of my knowledge and belief. Kansas Water Well Contractor's License No. 102. This Water Well Record was completed on (mo/day/yr) 11/9/84

under the business name of Layne-Western Company, Inc. by (signature) Diana L. Alumbaugh

INSTRUCTIONS: Use typewriter or ball point pen, PLEASE PRESS FIRMLY and PRINT clearly. Please fill in blanks, underline or circle the correct answers. Send top three copies to Kansas Department of Health and Environment, Division of Environment, Environmental Geology Section, Topeka, KS 66620. Send one to WATER WELL OWNER and retain one for your records.