

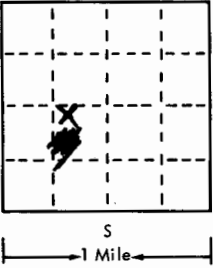
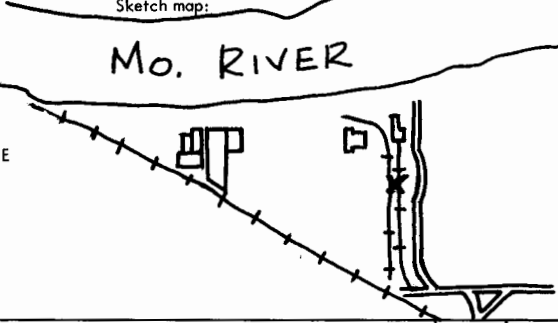
USE TYPEWRITER OR BALL POINT PEN-PRESS FIRMLY, PRINT CLEARLY.

WATER WELL RECORD
KSA 82a-1201-1215

Kansas State Dept. Of Health
(Water Well Contractors)
Forbes-Bldg. 740
Topeka, Kansas 66620

T R EW sec 1/4 1/4 1/4 No.

* NW-NE-SW cab

1 Location of well:	County WYANDOTTE	Township name	Fraction S 1/4	Section number 28	Town number 10 S.	Range number 25 W.
Distance and direction from nearest town or city: IN K.C. KS.			3 Owner of well: GARNEY CONST. CO.			
Street address of well location if in city: B.P.L.-QUINDARO DISTRICT			Address: 1331 N.W. VIVION RD. K.C. MO.			
Locate with "X" in section below: 			Sketch map: 			4 Well depth: 87.9 ft. Date of completion 3/16/76 Well diameter 42 in.
5 <input type="checkbox"/> Cable tool <input type="checkbox"/> Rotary <input type="checkbox"/> Driven <input type="checkbox"/> Dug <input type="checkbox"/> Hollow rod <input type="checkbox"/> Jetted <input type="checkbox"/> Bored <input checked="" type="checkbox"/> Reverse rotary						
6 Use: <input type="checkbox"/> Domestic <input type="checkbox"/> Public supply <input type="checkbox"/> Industry <input type="checkbox"/> Irrigation <input type="checkbox"/> Air conditioning <input type="checkbox"/> Commercial <input type="checkbox"/> Test well <input checked="" type="checkbox"/> DEWATERING						
7 Casing: Material STEEL Height: above/below Threaded <input type="checkbox"/> Welded <input checked="" type="checkbox"/> Surface 24 in. Diam. _____ Weight 29.31 lbs./ft. 12 in. to 47 ft. depth Drive shoe? <input type="checkbox"/> Yes <input checked="" type="checkbox"/> No _____ in. to _____ ft. depth						
2 WELL No. 1	Type and color of material	From	To	8 Screen: Manufacturer DOERR Type SLOTTED Dia. 12" Slot/gauze 1 GA. Length 40' Set between 47 ft. and 87 ft. Fittings: Gravel pack <input checked="" type="checkbox"/> Yes <input type="checkbox"/> No Size range of material 1/4"		
FILL		0	2'	9 Static water level: 21.5 ft. below land surface Date 3/16/76		
BROWN SANDY SILTY CLAY		2'	15'	Pumping level below land surfaces: 65 ft. after 120 hrs. pumping 350 g.p.m. _____ ft. after _____ hrs. pumping _____ g.p.m. Estimated maximum yield _____ g.p.m.		
BLUE CLAY		15'	26'	11 Water sample submitted: <input type="checkbox"/> Yes <input checked="" type="checkbox"/> No Date _____		
VERY FINE SAND		26'	40'	12 Well head completion: <input type="checkbox"/> Pitless adapter <input checked="" type="checkbox"/> Inches above grade		
MEDIUM TO COARSE SAND		40'	42'	<input checked="" type="checkbox"/> Well grouted? <input type="checkbox"/> Yes <input checked="" type="checkbox"/> No NATURAL BACKFILL <input type="checkbox"/> Neat cement <input type="checkbox"/> Bentonite <input checked="" type="checkbox"/> BACKFILL Depth: From 0 ft. to 87.9 ft.		
WOOD		42'	45'	14 Nearest source of possible contamination: COAL PILE ft. 100 Direction WEST Type _____ Well disinfected upon completion? <input type="checkbox"/> Yes <input checked="" type="checkbox"/> No		
VERY FINE SAND		45'	82'	15 Pump: <input checked="" type="checkbox"/> Not installed Manufacturer's name _____ Model number _____ HP _____ Volts _____ Length of drop pipe _____ ft. capacity _____ g.p.p. Type: <input type="checkbox"/> Submersible <input type="checkbox"/> Turbine <input type="checkbox"/> Jet <input type="checkbox"/> Reciprocating <input type="checkbox"/> Centrifugal <input type="checkbox"/> Other		
MEDIUM TO COARSE SAND		82'	86.4'	17 Water well contractor's certification: This well was drilled under my jurisdiction and this report is true to the best of my knowledge and belief. LAYNE-WESTERN CO. 149 Business name _____ License No. _____ Address 1010 W. 39TH - K.C. MO. Signed [Signature] Date 10/21/76 Authorized representative		
16 Remarks: elevation APPROX. 800' 750'						
Topography: <input type="checkbox"/> Hill <input type="checkbox"/> Slope <input type="checkbox"/> Upland <input checked="" type="checkbox"/> Valley						

10 25 W 28 S W 28 S W 28 S W

Forward the white, blue and pink copies to the Kansas State Dept. Of Health.

Form WWC-5