


1 LOCATION OF WATER WELL: Fraction SW 1/4 SW 1/4 NE 1/4 Section Number 28 Township Number T 10 S Range Number R 25 E/W  
 County: Wyandotte  
 Distance and direction from nearest town or city street address of well if located within city?

2 WATER WELL OWNER: Bennett-Rogers Pipe Coating MW-5 Board of Agriculture, Division of Water Resources  
 RR#, St. Address, Box #: 900 Knidelberger Road. Application Number:  
 City, State, ZIP Code: Kansas City, KS

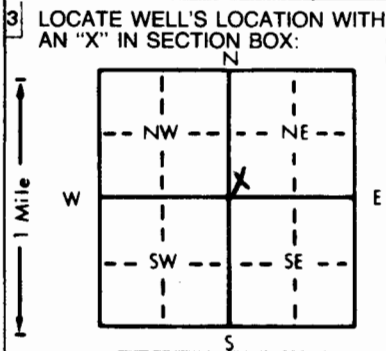

4 DEPTH OF COMPLETED WELL: 32 ft. ELEVATION:  
 Depth(s) Groundwater Encountered 1. 999 ft. 2. ft. 3. ft.  
 WELL'S STATIC WATER LEVEL 999 ft. below land surface measured on mo/day/yr  
 Pump test data: Well water was ft. after hours pumping gpm  
 Est. Yield gpm: Well water was ft. after hours pumping gpm  
 Bore Hole Diameter in. to ft., and in. to ft.  
 WELL WATER TO BE USED AS:  
 1 Domestic 3 Feedlot 6 Oil field water supply 9 Dewatering 11 Injection well  
 2 Irrigation 4 Industrial 7 Lawn and garden only 10 Monitoring well 12 Other (Specify below)  
 Was a chemical/bacteriological sample submitted to Department? Yes No; If yes, mo/day/yr sample was submitted  
 Water Well Disinfected? Yes No

5 TYPE OF BLANK CASING USED:  
 1 Steel 3 RMP (SR) 6 Asbestos-Cement 9 Other (specify below) CASING JOINTS: Glued Clamped  
2 PVC 4 ABS 7 Fiberglass Threaded  
 Blank casing diameter 2 in. to 4.75 ft. Dia. in. to ft. Dia. in. to ft.  
 Casing height above land surface 0 in., weight lbs./ft. Wall thickness or gauge No.  
 TYPE OF SCREEN OR PERFORATION MATERIAL:  
 1 Steel 3 Stainless steel 5 Fiberglass 7 PVC 10 Asbestos-cement  
 2 Brass 4 Galvanized steel 6 Concrete tile 9 ABS 11 Other (specify)  
 12 None used (open hole)  
 SCREEN OR PERFORATION OPENINGS ARE:  
 1 Continuous slot 3 Mill slot 5 Gauzed wrapped 8 Saw cut 11 None (open hole)  
 2 Louvered shutter 4 Key punched 6 Wire wrapped 9 Drilled holes  
 7 Torch cut 10 Other (specify)  
 SCREEN-PERFORATED INTERVALS: From 4.75 ft. to 24.75 ft. From ft. to ft.  
 From ft. to ft. From ft. to ft.  
 GRAVEL PACK INTERVALS: From 8 ft. to 25 ft. From ft. to ft.  
 From ft. to ft. From ft. to ft.

6 GROUT MATERIAL: 1 Neat cement 2 Cement grout 3 Bentonite 4 Other  
 Grout Intervals: From 0 ft. to 6 ft., From 6 ft. to 8 ft., From ft. to ft.  
 What is the nearest source of possible contamination:  
 1 Septic tank 4 Lateral lines 7 Pit privy 11 Fuel storage 14 Abandoned water well  
 2 Sewer lines 5 Cess pool 8 Sewage lagoon 12 Fertilizer storage 15 Oil well/Gas well  
 3 Watertight sewer lines 6 Seepage pit 9 Feedyard 13 Insecticide storage 16 Other (specify below)  
 Direction from well? How many feet?

FROM	TO	LITHOLOGIC LOG	FROM	TO	PLUGGING INTERVALS
0	0.3	Gravel			
0.3	9.4	Clay, some silt medium dark gray			
9.4	15	clay, dark yellowish brown with some gray			
15	17.4	clay, dark yellowish brown.			
17.4	30	Sand, fine, dark yellowish brown.			

7 CONTRACTOR'S OR LANDOWNER'S CERTIFICATION: This water well was (1) constructed, (2) reconstructed, or (3) plugged under my jurisdiction and was completed on (mo/day/year) 11/22/93 and this record is true to the best of my knowledge and belief. Kansas Water Well Contractor's License No. 438 This Water Well Record was completed on (mo/day/yr) 11/22/93 under the business name of Kansas City Testing Lab Inc. by (signature) [Signature]

INSTRUCTIONS: Use typewriter or ball point pen. PLEASE PRESS FIRMLY and PRINT clearly. Please fill in blanks, underline or circle the correct answers. Send top three copies to Kansas Department of Health and Environment, Bureau of Water, Topeka, Kansas 66620-0001. Telephone: 913-296-5545. Send one to WATER WELL OWNER and retain one for your records.