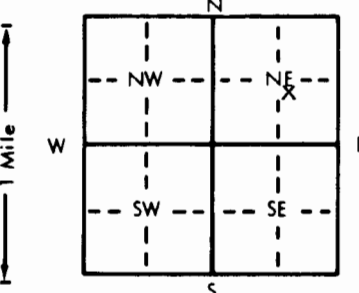


1 LOCATION OF WATER WELL: County: Wyandotte Fraction: SE 1/4 - NE SE 1/4 NE 1/4 Section Number: 30 Township Number: T 10 S Range Number: R 25 EW

Distance and direction from nearest town or city street address of well if located within city?
1950' NNW of 27th & Sewell Kansas City, Kansas

2 WATER WELL OWNER: Browning-Ferris Ind.
 RR#, St. Address, Box #: 3150 N. 7th Street Board of Agriculture, Division of Water Resources
 City, State, ZIP Code: Kansas City, Ks. 66115 Application Number:

3 LOCATE WELL'S LOCATION WITH AN "X" IN SECTION BOX:  4 DEPTH OF COMPLETED WELL: 42 ft. ELEVATION: 850 (Top)
 Depth(s) Groundwater Encountered 1. Dry ft. 2. ft. 3. ft.
 WELL'S STATIC WATER LEVEL Dry ft. below land surface measured on mo/day/yr
 Pump test data: Well water was ft. after hours pumping gpm
 Est. Yield gpm: Well water was ft. after hours pumping gpm
 Bore Hole Diameter: 4 in. to 42 ft., and in. to ft.
 WELL WATER TO BE USED AS: 5 Public water supply 8 Air conditioning 11 Injection well
 1 Domestic 3 Feedlot 6 Oil field water supply 9 Dewatering 12 Other (Specify below)
 2 Irrigation 4 Industrial 7 Lawn and garden only 10 Observation well
 Was a chemical/bacteriological sample submitted to Department? Yes.....No.....; If yes, mo/day/yr sample was submitted Water Well Disinfected? Yes No

5 TYPE OF BLANK CASING USED: 1 Steel 2 PVC 3 RMP (SR) 4 ABS 5 Wrought iron 6 Asbestos-Cement 7 Fiberglass 8 Concrete tile 9 Other (specify below) CASING JOINTS: Glued X Clamped Welded Threaded
 Blank casing diameter 1 in. to 42 ft., Dia. in. to ft., Dia. in. to ft.
 Casing height above land surface 24 in., weight lbs./ft. Wall thickness or gauge No. SCH 40
 TYPE OF SCREEN OR PERFORATION MATERIAL: 1 Steel 2 Brass 3 Stainless steel 4 Galvanized steel 5 Fiberglass 6 Concrete tile 7 PVC 8 RMP (SR) 9 ABS 10 Asbestos-cement 11 Other (specify) 12 None used (open hole)
 SCREEN OR PERFORATION OPENINGS ARE: 1 Continuous slot 2 Louvered shutter 3 Mill slot 4 Key punched 5 Gauzed wrapped 6 Wire wrapped 7 Torch cut 8 Saw cut 9 Drilled holes 11 None (open hole) 10 Other (specify)
 SCREEN-PERFORATED INTERVALS: From 32 ft. to 42 ft., From ft. to ft.
 GRAVEL PACK INTERVALS: From 27 ft. to 42 ft., From ft. to ft.

6 GROUT MATERIAL: 1 Neat cement 2 Cement grout 3 Bentonite 4 Other
 Grout intervals: From 0 ft. to 24 ft., From 24 ft. to 27 ft., From ft. to ft.
 What is the nearest source of possible contamination: 1 Septic tank 2 Sewer lines 3 Watertight sewer lines 4 Lateral lines 5 Cess pool 6 Seepage pit 7 Pit privy 8 Sewage lagoon 9 Feedyard 10 Livestock pens 11 Fuel storage 12 Fertilizer storage 13 Insecticide storage 14 Abandoned water well 15 Oil well/Gas well 16 Other (specify below) Unknown

Direction from well? How many feet?

FROM	TO	LITHOLOGIC LOG	FROM	TO	LITHOLOGIC LOG
0	7.5	Shale			
7.5	16	Limestone			
16	27	Shale			
27	32	Limestone & Shale (Interbedded)			
37	42	Limestone			

7 CONTRACTOR'S OR LANDOWNER'S CERTIFICATION: This water well was (1) constructed (2) reconstructed, or (3) plugged under my jurisdiction and was completed on (mo/day/year) 8-9-82 and this record is true to the best of my knowledge and belief. Kansas Water Well Contractor's License No. 399 This Water Well Record was completed on (mo/day/yr) 10-12-82 under the business name of Woodward-Clyde Consultants by (signature) Richard H. [unclear]

INSTRUCTIONS: Use typewriter or ball point pen, PLEASE PRESS FIRMLY and PRINT clearly. Please fill in blanks, underline or circle the correct answers. Send top three copies to Kansas Department of Health and Environment, Division of Environment, Environmental Geology Section, Topeka, KS 66620. Send one to WATER WELL OWNER and retain one for your records.

OFFICE USE ONLY
T
R
25
EW
SEC.
30
NW 1/4
SE 1/4
NE 1/4