

US TYPEWRITER OR BALL POINT PEN-PRESS FIRMLY, PRINT CLEARLY.

10 25 E 34 SW NE W
R EW sec 1/4 1/4 1/4 No.

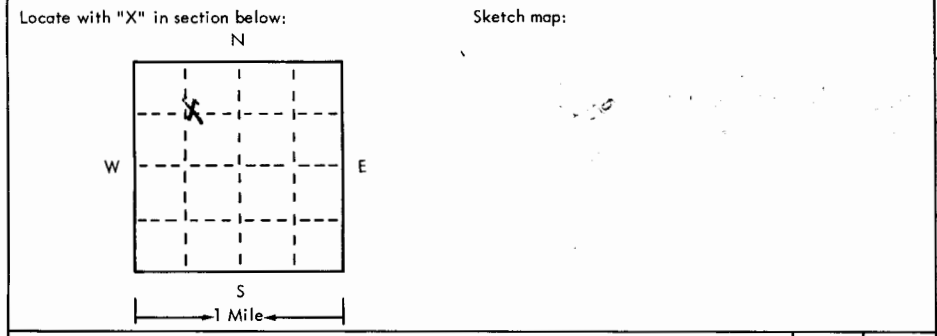
WATER WELL RECORD
KSA 82a-1201-1215

Kansas State Dept. Of Health
(Water Well Contractors)
Forbes-Bldg. 740
Topeka, Kansas 66620

Location on map but all sec boundaries run

1 Location of well:	County Wyandotte	Township name SWNE NW	Fraction 34	Section number 10	Town number 25 E	Range number
---------------------	----------------------------	---------------------------------	-----------------------	-----------------------------	----------------------------	--------------

Distance and direction from nearest town or city:	3 Owner of well: CertainTeed Products
Street address of well location if in city:	Address: Fairfax, Kansas



4 Well depth: 710' ft. Date of completion 9-20-75 Well diameter 6 in.
5 <input type="checkbox"/> Cable tool <input checked="" type="checkbox"/> Rotary <input type="checkbox"/> Driven <input type="checkbox"/> Dug <input type="checkbox"/> Hollow rod <input type="checkbox"/> Jetted <input type="checkbox"/> Bored <input type="checkbox"/> Reverse rotary
6 Use: <input type="checkbox"/> Domestic <input type="checkbox"/> Public supply <input type="checkbox"/> Industry <input type="checkbox"/> Irrigation <input type="checkbox"/> Air conditioning <input type="checkbox"/> Commercial <input checked="" type="checkbox"/> Test well <input type="checkbox"/>
7 Casing: Material steel Height: above/below Threaded <input type="checkbox"/> Welded <input type="checkbox"/> Surface 18 in. Diam 8 in. to 8 3/4 ft. depth Weight _____ lbs./ft. _____ Drive shoe? <input type="checkbox"/> Yes <input type="checkbox"/> No

2	Type and color of material	From	To
	alluvium	0	80
	shale	80	145
	sandstone	145	155
	shale	155	160
	sandstone & shale mix	160	200
	Lime	200	202
	shale	202	208
	lime in shale	208	212
	shale	212	216
	sandstone & shale	216	220
	lime	220	223
	Sandstone & shale	223	225
	shale & sandstone	225	231
	lime	231	233
	shale	233	238

8 Screen: Manufacturer none Type _____ Dia. _____ Slot/gauze _____ Length _____ Set between _____ ft. and _____ ft. _____ Fittings: Gravel pack <input type="checkbox"/> Yes <input type="checkbox"/> No Size range of material _____
9 Static water level: 35 ft. below land surface Date _____
10 Pumping level below land surfaces: _____ ft. after _____ hrs. pumping none p.m. _____ ft. after _____ hrs. pumping _____ g.p.m. Estimated maximum yield _____ g.p.m.
11 Water sample submitted: <input type="checkbox"/> Yes <input checked="" type="checkbox"/> No Date _____
12 Well head completion: below <input type="checkbox"/> Pitless adapter <input type="checkbox"/> Inches above grade
13 Well grouted? <input checked="" type="checkbox"/> Yes <input type="checkbox"/> No <input checked="" type="checkbox"/> Neat cement <input type="checkbox"/> Bentonite <input type="checkbox"/> _____ Depth: From 82 ft. to 0 ft.
14 Nearest source of possible contamination: ft. _____ Direction _____ Type _____ Well disinfected upon completion? <input type="checkbox"/> Yes <input type="checkbox"/> No
15 Pump: none <input type="checkbox"/> Not installed Manufacturer's name _____ Model number _____ HP _____ Volts _____ Length of drop pipe _____ ft. capacity _____ g.m.p. Type: <input type="checkbox"/> Submersible <input type="checkbox"/> Turbine <input type="checkbox"/> Jet <input type="checkbox"/> Reciprocating <input type="checkbox"/> Centrifugal <input type="checkbox"/> Other

16 Remarks: elevation **Well plugged and abandoned**
745 on **10-9-75**. Plug set at
Topography: **600 feet and at 212 feet**
 Hill Slope Upland Valley
cemented with Portland cement.

17 Water well contractor's certification:
This well was drilled under my jurisdiction and this report is true to the best of my knowledge and belief.
Cullum & Brown **121**
Business name License No.
Address: **204 Kansas City, Mo.**
Signed: *[Signature]* Date: **10-14-75**
Authorized representative

10 25 E 34 SW NE W

Forward the white, blue and pink copies to the Kansas State Dept. Of Health.

Form WWC-5

BR = 665 710

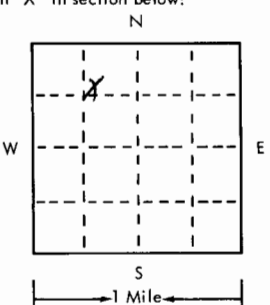
USE TYPEWRITER OR BALL POINT PEN-PRESS FIRMLY, PRINT CLEARLY.

T R EW sec 1/4 1/4 1/4 No.

WATER WELL RECORD
KSA 82a-1201-1215

Page 2

Kansas State Dept. Of Health
(Water Well Contractors)
Forbes-Bldg. 740
Topeka, Kansas 66620

1 Location of well:	County <i>Wyandotte</i>	Township name	Fraction	Section number <i>34</i>	Town number <i>10</i>	Range number <i>25</i>		
Distance and direction from nearest town or city: Street address of well location if in city:				3 Owner of well: Address:				
Locate with "X" in section below: 				Sketch map: PAGE 2		4 Well depth: _____ ft. Date of completion <i>9-20-75</i> Well diameter _____ in.		
2 Type and color of material				From	To	5 <input type="checkbox"/> Cable tool <input type="checkbox"/> Rotary <input type="checkbox"/> Driven <input type="checkbox"/> Dug <input type="checkbox"/> Hollow rod <input type="checkbox"/> Jetted <input type="checkbox"/> Bored <input type="checkbox"/> Reverse rotary		
				<i>shale and sandstone</i>		<i>238</i>	<i>239</i>	6 Use: <input type="checkbox"/> Domestic <input type="checkbox"/> Public supply <input type="checkbox"/> Industry <input type="checkbox"/> Irrigation <input type="checkbox"/> Air conditioning <input type="checkbox"/> Commercial <input type="checkbox"/> Test well <input type="checkbox"/> _____
				<i>shale</i>		<i>239</i>	<i>241</i>	7 Casing: Material _____ Height: above/below Threaded <input type="checkbox"/> Welded <input type="checkbox"/> Surface _____ in. Diam. _____ Weight _____ lbs./ft. _____ _____ in. to _____ ft. depth Drive shoe? <input type="checkbox"/> Yes <input type="checkbox"/> No _____ in. to _____ ft. depth!
				<i>Lime</i>		<i>241</i>	<i>242</i>	8 Screen: Manufacturer _____ Type _____ Dia. _____ Slot/gauze _____ Length _____ Set between _____ ft. and _____ ft. _____ Fittings: Gravel pack <input type="checkbox"/> Yes <input type="checkbox"/> No Size range of material _____
				<i>Shale w/lime</i>		<i>242</i>	<i>266</i>	9 Static water level: _____ ft. below land surface Date _____
				<i>shale & sandstone</i>		<i>266</i>	<i>269</i>	10 Pumping level below land surfaces: _____ ft. after _____ hrs. pumping _____ g.p.m. _____ ft. after _____ hrs. pumping _____ g.p.m. Estimated maximum yield _____ g.p.m.
				<i>Lime</i>		<i>269</i>	<i>272</i>	11 Water sample submitted: <input type="checkbox"/> Yes <input type="checkbox"/> No Date _____
				<i>shale</i>		<i>272</i>	<i>287</i>	12 Well head completion: <input type="checkbox"/> Pitless adapter <input type="checkbox"/> Inches above grade
				<i>slate</i>		<i>287</i>	<i>292</i>	13 Well grouted? <input type="checkbox"/> Yes <input type="checkbox"/> No <input type="checkbox"/> Neat cement <input type="checkbox"/> Bentonite <input type="checkbox"/> _____ Depth: From _____ ft. to _____ ft.
				<i>shale</i>		<i>292</i>	<i>300</i>	14 Nearest source of possible contamination: ft. _____ Direction _____ Type _____ Well disinfected upon completion? <input type="checkbox"/> Yes <input type="checkbox"/> No
				<i>lime & shale</i>		<i>300</i>	<i>305</i>	15 Pump: <input type="checkbox"/> Not installed Manufacturer's name _____ Model number _____ HP _____ Volts _____ Length of drop pipe _____ ft. capacity _____ g.m.p. Type: <input type="checkbox"/> Submersible <input type="checkbox"/> Turbine <input type="checkbox"/> Jet <input type="checkbox"/> Reciprocating <input type="checkbox"/> Centrifugal <input type="checkbox"/> Other
				<i>sandstone</i>		<i>305</i>	<i>318</i>	16 Remarks: elevation Topography: <input type="checkbox"/> Hill <input type="checkbox"/> Slope <input type="checkbox"/> Upland <input type="checkbox"/> Valley
				<i>slate</i>		<i>318</i>	<i>327</i>	
				<i>shale & sandstone</i>		<i>327</i>	<i>334</i>	
				<i>Lime</i>		<i>334</i>	<i>342</i>	
<i>shale</i>		<i>342</i>	<i>347</i>					
<i>lime (use a second sheet if needed)</i>		<i>347</i>	<i>350</i>	17 Water well contractor's certification: This well was drilled under my jurisdiction and this report is true to the best of my knowledge and belief. <i>Callum + Brown</i> Business name _____ License No. _____ Address _____ Signed _____ Date _____ Authorized representative				

Forward the white, blue and pink copies to the Kansas State Dept. Of Health.

Form WWC-5

USE TYPEWRITER OR BALL POINT PEN—PRESS FIRMLY, PRINT CLEARLY.

WATER WELL RECORD
KSA 82a-1201-1215

Page 3

T R EW sec 1/4 1/4 1/4 No.

Kansas State Dept. Of Health
(Water Well Contractors)
Forbes-Bldg. 740
Topeka, Kansas 66620

1 Location of well:	County <i>Wyandotte</i>	Township name	Fraction	Section number <i>34</i>	Town number <i>10</i>	Range number <i>25</i>
Distance and direction from nearest town or city: Street address of well location if in city:				3 Owner of well: Address:		
Locate with "X" in section below: <div style="text-align: center;"> </div>				Sketch map: <i>Page 3</i>		
2 Type and color of material				From	To	4 Well depth: _____ ft. Date of completion <i>9-20-75</i> Well diameter _____ in.
slate				350	362	5 <input type="checkbox"/> Cable tool <input type="checkbox"/> Rotary <input type="checkbox"/> Driven <input type="checkbox"/> Dug <input type="checkbox"/> Hollow rod <input type="checkbox"/> Jetted <input type="checkbox"/> Bored <input type="checkbox"/> Reverse rotary
lime & shale mix				362	365	6 Use: <input type="checkbox"/> Domestic <input type="checkbox"/> Public supply <input type="checkbox"/> Industry <input type="checkbox"/> Irrigation <input type="checkbox"/> Air conditioning <input type="checkbox"/> Commercial <input type="checkbox"/> Test well <input type="checkbox"/> _____
lime shale				365	370	7 Casing: Material _____ Height: above/below Threaded <input type="checkbox"/> Welded <input type="checkbox"/> Surface _____ in. Diam. _____ Weight _____ lbs./ft. _____ _____ in. to _____ ft. depth Drive shoe? <input type="checkbox"/> Yes <input type="checkbox"/> No _____ in. to _____ ft. depth
lime w/shale				370	390	8 Screen: Manufacturer _____ Type _____ Dia. _____ Slot/gauze _____ Length _____ Set between _____ ft. and _____ ft. _____ Fittings: Gravel pack <input type="checkbox"/> Yes <input type="checkbox"/> No Size range of material _____
shale				390	394	9 Static water level: _____ ft. below land surface Date _____
sandstone				394	396	10 Pumping level below land surfaces: _____ ft. after _____ hrs. pumping _____ g.p.m. _____ ft. after _____ hrs. pumping _____ g.p.m. Estimated maximum yield _____ g.p.m.
shale & sandstone				396	410	11 Water sample submitted: <input type="checkbox"/> Yes <input type="checkbox"/> No Date _____
slate				410	430	12 Well head completion: <input type="checkbox"/> Pitless adapter <input type="checkbox"/> Inches above grade
shale				430	443	13 Well grouted? <input type="checkbox"/> Yes <input type="checkbox"/> No <input type="checkbox"/> Neat cement <input type="checkbox"/> Bentonite <input type="checkbox"/> _____ Depth: From _____ ft. to _____ ft.
slate & shale				443	450	14 Nearest source of possible contamination: ft. _____ Direction _____ Type _____ Well disinfected upon completion? <input type="checkbox"/> Yes <input type="checkbox"/> No
sandstone				450	453	15 Pump: <input type="checkbox"/> Not installed Manufacturer's name _____ Model number _____ HP _____ Volts _____ Length of drop pipe _____ ft. capacity _____ g.m.p. Type: <input type="checkbox"/> Submersible <input type="checkbox"/> Turbine <input type="checkbox"/> Jet <input type="checkbox"/> Reciprocating <input type="checkbox"/> Centrifugal <input type="checkbox"/> Other
shale				453	459	
lime				459	462	
shale				462	469	
lime				469	470	
shale				470	476	
slate				476	482	
shale & slate				482	492	
sandstone & shale				492	510	
shale				510	513	
sandstone				513	518	
slate				518	520	
sandstone & slate mix <small>(Use a second sheet if needed)</small>				520	525	
16 Remarks: elevation Topography: <input type="checkbox"/> Hill <input type="checkbox"/> Slope <input type="checkbox"/> Upland <input type="checkbox"/> Valley						17 Water well contractor's certification: This well was drilled under my jurisdiction and this report is true to the best of my knowledge and belief. <i>Callum & Brown</i> Business name _____ License No. _____ Address _____ Signed _____ Date _____ Authorized representative

Forward the white, blue and pink copies to the Kansas State Dept. Of Health.

Form WWC-5

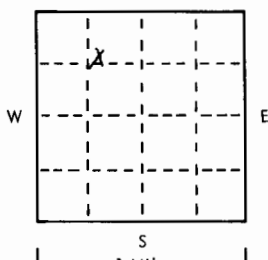
USE TYPEWRITER OR BALL POINT PEN-PRESS FIRMLY, PRINT CLEARLY.

WATER WELL RECORD
KSA 82a-1201-1215

Page 4

T R EW sec 1/4 1/4 1/4 No.

Kansas State Dept. Of Health
(Water Well Contractors)
Forbes-Bldg. 740
Topeka, Kansas 66620

1 Location of well:	County <i>Wyandotte</i>	Township name	Fraction	Section number <i>34</i>	Town number <i>10S</i>	Range number <i>25E</i>
Distance and direction from nearest town or city: Street address of well location if in city:				3 Owner of well: Address:		
Locate with "X" in section below: N  W E S 1 Mile				Sketch map: <i>Page 4</i>		
2 Type and color of material				From		To
shale & slate				525		540
slate				540		543
lime				543		544
slate				544		545
sandstone				545		551
slate & shale				551		564
sandstone				564		571
shale & slate				571		591
sandstone				591		594
shale				594		595
shale				595		607
sandstone				607		609
sand & sandstone				609		618
slate				618		635
shale				635		639
sandstone				639		644
shale				644		655
sandstone & shale				655		661
lime				661		662
shale				662		677
shale & slate				677		683
aerite				683		685
slate & shale				685		691
shale				691		699
slate				699		702
Mississippian (if needed)				702		710TD
16 Remarks: elevation Topography: <input type="checkbox"/> Hill <input type="checkbox"/> Slope <input type="checkbox"/> Upland <input type="checkbox"/> Valley				17 Water well contractor's certification: This well was drilled under my jurisdiction and this report is true to the best of my knowledge and belief. <i>William Brown</i> Business name _____ License No. _____ Address _____ Signed _____ Date _____ Authorized representative		

Forward the white, blue and pink copies to the Kansas State Dept. Of Health.

Form WWC-5