


Well #51

1 LOCATION OF WATER WELL: County: Wyandotte Fraction: NE 1/4 SE 1/4 SE 1/4 Section Number: 34 Township Number: T 10 S Range Number: R 25 W

Distance and direction from nearest town or city street address of well if located within city?  
Kansas City Kansas

2 WATER WELL OWNER: Phillips Petroleum Company  
 RR#, St. Address, Box #: Bartlesville, Oklahoma Board of Agriculture, Division of Water Resources  
 City, State, ZIP Code: 74004 Application Number:

3 LOCATE WELL'S LOCATION WITH AN "X" IN SECTION BOX:

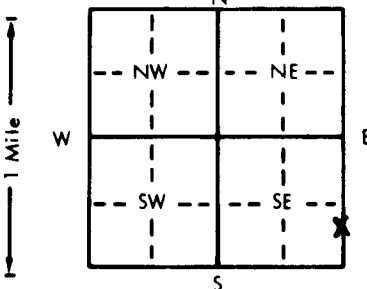

4 DEPTH OF COMPLETED WELL: 25.0 ft. ELEVATION:  
 Depth(s) Groundwater Encountered 1. @ 18.0 ft. 2. ft. 3. ft.  
 WELL'S STATIC WATER LEVEL: ft. below land surface measured on mo/day/yr  
 Pump test data: Well water was ft. after hours pumping gpm  
 Est. Yield gpm: Well water was ft. after hours pumping gpm  
 Bore Hole Diameter: 5" in. to 25.0 ft., and in. to ft.  
 WELL WATER TO BE USED AS: 5 Public water supply 8 Air conditioning 11 Injection well  
 1 Domestic 3 Feedlot 6 Oil field water supply 9 Dewatering 12 Other (Specify below)  
 2 Irrigation 4 Industrial 7 Lawn and garden only 10 Observation well  
 Was a chemical/bacteriological sample submitted to Department? Yes.....No.....X.....; If yes, mo/day/yr sample was submitted Water Well Disinfected? Yes No X

5 TYPE OF BLANK CASING USED: 1 Steel 3 RMP (SR) 5 Wrought iron 8 Concrete tile CASING JOINTS: Glued Clamped  
PVC 4 ABS 6 Asbestos-Cement 9 Other (specify below) Welded  
 7 Fiberglass Threaded X  
 Blank casing diameter: 2" in. to 25.0 ft., Dia. in. to ft., Dia. in. to ft.  
 Casing height above land surface: 24' in., weight lbs./ft. Wall thickness or gauge No. sch-40

TYPE OF SCREEN OR PERFORATION MATERIAL: 1 Steel 3 Stainless steel 5 Fiberglass 8 RMP (SR) 10 Asbestos-cement  
 2 Brass 4 Galvanized steel 6 Concrete tile 9 ABS 12 None used (open hole)

SCREEN OR PERFORATION OPENINGS ARE: 1 Continuous slot 2 Mill slot 3 Mill slot 4 Key punched 5 Gauzed wrapped 6 Wire wrapped 7 Torch cut 8 Saw cut 11 None (open hole)  
 2 Louvered shutter 4 Key punched 7 Torch cut 10 Other (specify)

SCREEN-PERFORATED INTERVALS: From 05.0 ft. to 25.0 ft., From ft. to ft.  
 GRAVEL PACK INTERVALS: From 05.0 ft. to 25.0 ft., From ft. to ft.

6 GROUT MATERIAL: 1 Neat cement 2 Bentonite 3 Bentonite 4 Other  
 Grout Intervals: From 4.50 ft. to 5.0 ft., From 0 ft. to 4.5 ft., From ft. to ft.  
 What is the nearest source of possible contamination: 1 Septic tank 4 Lateral lines 7 Pit privy 10 Livestock pens 14 Abandoned water well  
 2 Sewer lines 5 Cess pool 8 Sewage lagoon 11 Fuel storage 15 Oil well/Gas well  
 3 Watertight sewer lines 6 Seepage pit 9 Feedyard 12 Fertilizer storage 16 Other (specify below)  
 13 Insecticide storage refinery tanks  
 Direction from well? How many feet? 60' and lines

FROM	TO	LITHOLOGIC LOG	FROM	TO	LITHOLOGIC LOG
0	8.0	lt brown clays - silt and gravel - moist	03		
8.0	18.0	dk grey clayey silt moist	03		
18.0	25.0	grey silty sand - wet	02		

7 CONTRACTOR'S OR LANDOWNER'S CERTIFICATION: This water well was (1) constructed (2) reconstructed, or (3) plugged under my jurisdiction and was completed on (mo/day/year) 1-21-83 and this record is true to the best of my knowledge and belief. Kansas Water Well Contractor's License No. 438 This Water Well Record was completed on (mo/day/yr) 1-21-83 under the business name of K C Testing Lab by (signature) Richard C Zander

INSTRUCTIONS: Use typewriter or ball point pen, PLEASE PRESS FIRMLY and PRINT clearly. Please fill in blanks, underline or circle the correct answers. Send top three copies to Kansas Department of Health and Environment, Division of Environment, Environmental Geology Section, Topeka, KS 66620. Send one to WATER WELL OWNER and retain one for your records.

OFFICE USE ONLY  
 T 10  
 R 25  
 W  
 SEC: 34  
 NE 1/4  
 SE 1/4