


1] LOCATION OF WATER WELL: County: **WYANDOTTE** Fraction: **NW 1/4 SW 1/4 SW 1/4** Section Number: **35** Township Number: **T 10 S** Range Number: **R 25 E**

Distance and direction from nearest town or city street address of well if located within city?
1/4 MILE DUE EAST OF FAIRFAY TRFWY. - KCK

2] WATER WELL OWNER: **PHILLIPS PIPELINE**
 RR#, St. Address, Box #: **PO BOX 1236** Board of Agriculture, Division of Water Resource
 City, State, ZIP Code: **KC, KS 66117** Application Number: **NOT AVAILABLE**

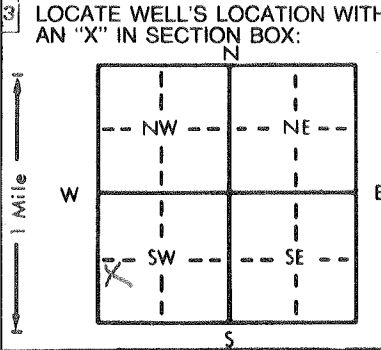

4] DEPTH OF COMPLETED WELL: **35'-8"** ft. ELEVATION: _____
 Depth(s) Groundwater Encountered 1. **24'-1"** ft. 2. _____ ft. 3. _____ ft.
 WELL'S STATIC WATER LEVEL: **24'-1"** ft. below land surface measured on mo/day/yr **11-2-07**
 Pump test data: Well water was _____ ft. after _____ hours pumping _____ gpm
 Est. Yield **500** gpm: Well water was _____ ft. after _____ hours pumping _____ gpm
 Bore Hole Diameter: _____ in. to _____ ft., and _____ in. to _____ ft.
 WELL WATER TO BE USED AS:
 1 Domestic 2 Irrigation **4 Industrial** 5 Public water supply 6 Oil field water supply 7 Lawn and garden only 8 Air conditioning 9 Dewatering 10 Observation well 11 Injection well 12 Other (Specify below)
 Was a chemical/bacteriological sample submitted to Department? Yes _____ No **X**; If yes, mo/day/yr sample was submitted _____
 Water Well Disinfected? Yes **X** No _____

5] TYPE OF BLANK CASING USED:
1 Steel 2 PVC 3 RMP (SR) 4 ABS 5 Wrought iron 6 Asbestos-Cement 7 Fiberglass 8 Concrete tile 9 Other (specify below) CASING JOINTS: Glued _____ Clamped _____ Welded **X** Threaded _____
 Blank casing diameter: **30** in. to _____ ft., Dia. _____ in. to _____ ft., Dia. _____ in. to _____ ft.
 Casing height above land surface: **0** in., weight _____ lbs./ft. Wall thickness or gauge No. _____
 TYPE OF SCREEN OR PERFORATION MATERIAL:
1 Steel 2 Brass 3 Stainless steel 4 Galvanized steel 5 Fiberglass 6 Concrete tile 7 PVC 8 RMP (SR) **11 Other (specify) UNKNOWN** 10 Asbestos-cement 12 None used (open hole)
 SCREEN OR PERFORATION OPENINGS ARE:
1 Continuous slot 2 Louvered shutter 3 Mill slot 4 Key punched 5 Gauzed wrapped 6 Wire wrapped 7 Torch cut 8 Saw cut 9 Drilled holes 10 Other (specify) **UNKNOWN** 11 None (open hole)
 SCREEN-PERFORATED INTERVALS: From **UNKNOWN** ft. to _____ ft., From _____ ft. to _____ ft.
 GRAVEL PACK INTERVALS: From **UNKNOWN** ft. to _____ ft., From _____ ft. to _____ ft.

6] GROUT MATERIAL: **1 Neat cement** **3** **2 Cement grout** 3 Bentonite 4 Other _____
 Grout Intervals: From **UNKNOWN** ft. to _____ ft., From _____ ft. to _____ ft.
 What is the nearest source of possible contamination:
1 Septic tank 2 Sewer lines 3 Watertight sewer lines 4 Lateral lines 5 Cess pool 6 Seepage pit 7 Pit privy 8 Sewage lagoon 9 Feedyard 10 Livestock pens 11 **Fuel storage** 12 Insecticide storage 14 Abandoned water well 15 Oil well/Gas well 16 Other (specify below)

Direction from well? _____ How many feet? _____

FROM	TO	LITHOLOGIC LOG	FROM	TO	LITHOLOGIC LOG
35'-8"	24'-1"	CHLORINATED GRAVEL			
24'-1"	3'-0"	CEMENT GROUT			
3'-0"	0'-0"	COMPACTED CLAYS			
		CASING CUT OFF			
		3 FT BELOW GRADE.			

7] CONTRACTOR'S OR LANDOWNER'S CERTIFICATION: This water well was (1) constructed, (2) reconstructed, or **(3) plugged** under my jurisdiction and was completed on (mo/day/year) **11-2-07** and this record is true to the best of my knowledge and belief. Kansas Water Well Contractor's License No. **102** This Water Well Record was completed on (mo/day/yr) **11-12-07** under the business name of **LAYNE-WESTERN** by (signature) **Paul W. Fankh**