


1 LOCATION OF WATER WELL: Fraction NW 1/4 SW 1/4 NW 1/4 Section Number 28 Township Number T 10 S Range Number R 25 EW  
 County: WYANDOTTE

Distance and direction from nearest town or city street address of well if located within city?  
 Quindaro Power Plant, 347 North James St. Kansas City, Kansas 66101

2 WATER WELL OWNER: Board of Public Utilities  
 RR#, St. Address, Box #: 700 Minnesota Ave Board of Agriculture, Division of Water Resources  
 City, State, ZIP Code: Kansas City, Kansas 66101 Application Number:

3 LOCATE WELL'S LOCATION WITH AN "X" IN SECTION BOX:

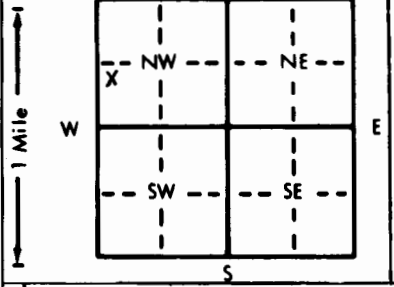

4 DEPTH OF COMPLETED WELL: 34.25 ft. ELEVATION: 755  
 Depth(s) Groundwater Encountered 1. None ATD ft. 2. ft. 3. ft.

WELL'S STATIC WATER LEVEL 28.25 ft. below land surface measured on mo/day/yr 7/27/94  
 Pump test data: Well water was ft. after hours pumping gpm  
 Est. Yield gpm: Well water was ft. after hours pumping gpm

Bore Hole Diameter: 16 in. to 35.5 ft., and in. to ft.  
 WELL WATER TO BE USED AS: 5 Public water supply 8 Air conditioning 11 Injection well  
 1 Domestic 3 Feedlot 6 Oil field water supply 9 Dewatering 12 Other (Specify below)  
 2 Irrigation 4 Industrial 7 Lawn and garden only 10 Observation well

Was a chemical/bacteriological sample submitted to Department? Yes No  No   
 If yes, mo/day/yr sample was submitted

Water Well Disinfected? Yes  No

5 TYPE OF BLANK CASING USED: 1 Steel 3 RMP (SR) 5 Wrought iron 8 Concrete tile CASING JOINTS: Glued Clamped  
 2 PVC 4 ABS 6 Asbestos-Cement 9 Other (specify below) Welded  
 7 Fiberglass Threaded

Blank casing diameter 4 in. to 34.25 ft., Dia in. to ft., Dia in. to ft.  
 Casing height above land surface 24 in., weight lbs./ft. Wall thickness or gauge No. Sch. 40

TYPE OF SCREEN OR PERFORATION MATERIAL: 1 Steel 3 Stainless steel 5 Fiberglass 8 RMP (SR) 10 Asbestos-cement  
 2 Brass 4 Galvanized steel 6 Concrete tile 9 ABS 11 Other (specify)  
 12 None used (open hole)

SCREEN OR PERFORATION OPENINGS ARE: 1 Continuous slot 3 Mill slot 5 Gauzed wrapped 8 Saw cut 11 None (open hole)  
 2 Louvered shutter 4 Key punched 6 Wire wrapped 9 Drilled holes  
 7 Torch cut 10 Other (specify)

SCREEN-PERFORATED INTERVALS: From 19.0 ft. to 34.0 ft., From ft. to ft.  
 GRAVEL PACK INTERVALS: From 17.0 ft. to 35.5 ft., From ft. to ft.

6 GROUT MATERIAL: 1 Neat cement 2 Cement grout 3 Bentonite 4 Other  
 Grout Intervals: From 0 ft. to 15.0 ft., From 15.0 ft. to 17 ft., From ft. to ft.

What is the nearest source of possible contamination: 1 Septic tank 4 Lateral lines 7 Pit privy 10 Livestock pens 14 Abandoned water well  
 2 Sewer lines 5 Cess pool 8 Sewage lagoon 11 Fuel storage 15 Oil well/Gas well  
 3 Watertight sewer lines 6 Seepage pit 9 Feedyard 12 Fertilizer storage 16 Other (specify below)  
 13 Insecticide storage

Direction from well? NORTH EAST How many feet? 1000 ft

FROM	TO	LITHOLOGIC LOG	FROM	TO	LITHOLOGIC LOG
0	9.0	DK brn low Plastic silty CLAY FILL			
9.0	17.0	dk gray low Plastic silty CLAY CL			
17.0	22.5	blue gray med Plastic CLAY CL-CH			
22.5	24.0	blue gray low Plastic CLAY CL			
24.0	35.5	blue gray v. f. SAND w/ fine SM-SC			

7 CONTRACTOR'S OR LANDOWNER'S CERTIFICATION: This water well was (1) constructed, (2) reconstructed, or (3) plugged under my jurisdiction and was completed on (mo/day/year) 7/25/94 and this record is true to the best of my knowledge and belief. Kansas Water Well Contractor's License No. 377 This Water Well Record was completed on (mo/day/yr) 8-15-94 under the business name of WYANDOTTE-CITY CONTRACTORS by (signature) Robert S. McWhorter

INSTRUCTIONS: Use typewriter or ball point pen. PLEASE PRESS FIRMLY and PRINT clearly. Please fill in blanks, underline or circle the correct answers. Send top three copies to Kansas Department of Health and Environment, Bureau of Water Protection, Topeka, Kansas 66620-7320, Telephone: 913-862-9360. Send one to WATER WELL OWNER and retain one for your records.