


1 LOCATION OF WATER WELL: County: Wyandotte Fraction: SE 1/4 NE 1/4 NW 1/4 Section Number: 34 Township Number: T 10 S Range Number: R 25 EW
 Distance and direction from nearest town or city street address of well if located within city?
103 Funston, Kansas City, KS.

2 WATER WELL OWNER: Carl Privitera Sr.
 RR#, St. Address, Box #: 909 Troost Board of Agriculture, Division of Water Resources
 City, State, ZIP Code: Kansas City, Ks. 64106 Application Number:

3 LOCATE WELL'S LOCATION WITH AN "X" IN SECTION BOX:

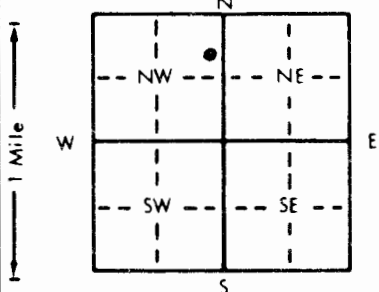

4 DEPTH OF COMPLETED WELL: 18'6" ft. ELEVATION:
 Depth(s) Groundwater Encountered: 1.13.50 ft. 2. ft. 3. ft.
 WELL'S STATIC WATER LEVEL: 1386 ft. below land surface measured on mo/day/yr: 7-29-94

Pump test data: Well water was _____ ft. after _____ hours pumping _____ gpm
 Est. Yield _____ gpm Well water was _____ ft. after _____ hours pumping _____ gpm
 Bore Hole Diameter: 8 1/2 in. to 18 6" ft. and _____ in. to _____ ft.
 WELL WATER TO BE USED AS:
 1 Domestic 3 Feedlot 6 Oil field water supply 9 Dewatering 11 Injection well
 2 Irrigation 4 Industrial 7 Lawn and garden only 10 Monitoring well 12 Other (Specify below)
 Was a chemical/bacteriological sample submitted to Department? Yes _____ No X If yes, mo/day/yr sample was submitted _____
 Water Well Disinfected? Yes _____ No Yes

5 TYPE OF BLANK CASING USED:
 1 Steel 3 RMP (SR) 5 Wrought iron 8 Concrete tile CASING JOINTS: Glued _____ Clamped _____
2 PVC 4 ABS 6 Asbestos-Cement 9 Other (specify below) Welded _____
 7 Fiberglass Threaded _____ X

Blank casing diameter: 2.375 in. to 8' ft. Dia _____ in. to _____ ft. Dia _____ in. to SDR 13 ft.
 Casing height above land surface: 6' Fresh Mount weight _____ lbs./ft. Wall thickness or gauge No. Sch 40

TYPE OF SCREEN OR PERFORATION MATERIAL:
 1 Steel 3 Stainless steel 5 Fiberglass 8 RMP (SR) 10 Asbestos-cement
 2 Brass 4 Galvanized steel 6 Concrete tile 9 ABS 11 Other (specify) _____
 12 None used (open hole)

SCREEN OR PERFORATION OPENINGS ARE:
 1 Continuous slot 3 Mill slot 5 Gauzed wrapped 8 Saw cut 11 None (open hole)
 2 Louvered shutter 4 Key punched 6 Wire wrapped 9 Drilled holes
 7 Torch cut 10 Other (specify) _____

SCREEN-PERFORATED INTERVALS: From 18' ft. to 8' ft. From _____ ft. to _____ ft.
 GRAVEL PACK INTERVALS: From 18 6" ft. to 6' ft. From _____ ft. to _____ ft.

6 GROUT MATERIAL: 1 Neat cement 2 Cement grout 3 Bentonite 4 Other _____
 Grout Intervals: From 6' ft. to 3' ft. From 3' ft. to 0' ft. From _____ ft. to _____ ft.

What is the nearest source of possible contamination:
 1 Septic tank 4 Lateral lines 7 Pit privy 10 Livestock pens 14 Abandoned water well
 2 Sewer lines 5 Cess pool 8 Sewage lagoon 11 Fuel storage FUEL 15 Oil well/Gas well
 3 Watertight sewer lines 6 Seepage pit 9 Feedyard 12 Fertilizer storage 16 Other (specify below)
 13 Insecticide storage
 Direction from well? North How many feet? 70'

FROM	TO	LITHOLOGIC LOG	FROM	TO	PLUGGING INTERVALS
0	.75	Concrete			
.75	2.25	Dk gray sandy clay, moist, no odor, iron oxide.			
2.25	13.25	Med brn silty clay, moist, no odor, iron oxides. w/ slight gray clay mottling at 5'.			
13.25	18'6"	Med brn sandy silt to silty sand, wet, no odor, laminated.			

7 CONTRACTOR'S OR LANDOWNER'S CERTIFICATION: This water well was (1) constructed, (2) reconstructed, or (3) plugged under my jurisdiction and was completed on (mo/day/year) 7-26-94 and this record is true to the best of my knowledge and belief. Kansas Water Well Contractor's License No. 539 This Water Well Record was completed on (mo/day/yr) 8-21-94 under the business name of JB Environmental Drilling by signature James Becker