


1 LOCATION OF WATER WELL: Fraction SW 1/4 SW 1/4 SW 1/4 Section Number 27 Township Number T 10 S Range Number R 25 E  
 County: WYANDOTT

Distance and direction from nearest town or city street address of well if located within city?  
3126 BRINKERHOFF RD, K.C. KS 66115 Well # MW 13A

2 WATER WELL OWNER: UNISON TRANSFORMER SERVICES  
 RR#, St. Address, Box #: 3126 BRINKERHOFF RD Board of Agriculture, Division of Water Resources  
 City, State, ZIP Code: KANSAS CITY, KANSAS 66115 Application Number:

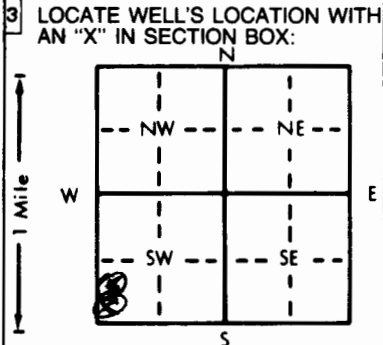

4 DEPTH OF COMPLETED WELL: 30 ft. ELEVATION:  
 Depth(s) Groundwater Encountered 1. .... ft. 2. .... ft. 3. .... ft.  
 WELL'S STATIC WATER LEVEL 17.4 ft. below land surface measured on mo/day/yr 5/15/94  
 Pump test data: Well water was .... ft. after .... hours pumping .... gpm  
 Est. Yield .... gpm: Well water was .... ft. after .... hours pumping .... gpm  
 Bore Hole Diameter: 8 in. to 33 ft., and .... in. to .... ft.  
 WELL WATER TO BE USED AS:  
 5 Public water supply 8 Air conditioning 11 Injection well  
 1 Domestic 3 Feedlot 6 Oil field water supply 9 Dewatering 12 Other (Specify below)  
 2 Irrigation 4 Industrial 7 Lawn and garden only 10 Monitoring well  
 Was a chemical/bacteriological sample submitted to Department? Yes.....No...X....; If yes, mo/day/yr sample was submitted  
 Water Well Disinfected? Yes No X

5 TYPE OF BLANK CASING USED:  
 1 Steel 3 RMP (SR) 5 Wrought iron 8 Concrete tile CASING JOINTS: Glued ..... Clamped .....  
2 PVC 4 ABS 6 Asbestos-Cement 9 Other (specify below) Welded .....  
 7 Fiberglass Threaded... X .....  
 Blank casing diameter 2 in. to 20 ft., Dia. .... in. to .... ft., Dia. .... in. to .... ft.  
 Casing height above land surface 0 in., weight 9.70 lbs./ft. Wall thickness or gauge No. SCREEN 40  
 TYPE OF SCREEN OR PERFORATION MATERIAL:  
 1 Steel 3 Stainless steel 5 Fiberglass 8 RMP (SR) 10 Asbestos-cement  
 2 Brass 4 Galvanized steel 6 Concrete tile 9 ABS 11 Other (specify) .....  
 12 None used (open hole)  
 SCREEN OR PERFORATION OPENINGS ARE:  
 1 Continuous slot 3 Mill slot 5 Gauzed wrapped 8 Saw cut 11 None (open hole)  
 2 Louvered shutter 4 Key punched 6 Wire wrapped 9 Drilled holes  
 7 Torch cut 10 Other (specify) .....  
 SCREEN-PERFORATED INTERVALS: From 20 ft. to 30 ft., From .... ft. to .... ft.  
 From .... ft. to .... ft., From .... ft. to .... ft.  
 GRAVEL PACK INTERVALS: From 17 ft. to 30 ft., From .... ft. to .... ft.  
 From .... ft. to .... ft., From .... ft. to .... ft.

6 GROUT MATERIAL: 1 Neat cement 2 Cement grout 3 Bentonite 4 Other .....  
 Grout Intervals: From 0 ft. to 14 ft., From 14 ft. to 17 ft., From .... ft. to .... ft.  
 What is the nearest source of possible contamination:  
 1 Septic tank 4 Lateral lines 7 Pit privy 10 Livestock pens 14 Abandoned water well  
 2 Sewer lines 5 Cess pool 8 Sewage lagoon 11 Fuel storage 15 Oil well/Gas well  
 3 Watertight sewer lines 6 Seepage pit 9 Feedyard 12 Fertilizer storage 16 Other (specify below)  
CORROD INDUSTRIAL FACILITY  
 Direction from well? SOUTH How many feet? 10 FT

FROM	TO	LITHOLOGIC LOG	FROM	TO	PLUGGING INTERVALS
0	1	FILL			
1	3.5	DK BRN CLAY & SILT ML			
3.5	9.5	MIX W/ PLASTIC SLT-CL & CLAY SILT (MLT CL)			
9.5	10.5	LT BRN V FINE SILTY SAND (SM)			
10.5	14	V FINE SILTY SAND W/ SANDY SILT (SM W/ ML)			
14	19	LT BRN V FINE SILTY SAND (SM)			
19	21	PINE POOLY GRADED SAND (SP)			
21	29	PINE-MED SAND W/ TR SILTY SAND (SP W/ SM)			
29	42	MEDIUM SAND W/ SOME COARSE (SP)			
42	47	V FINE SILTY SAND - SANDY SILT (SM)			
47	52	Med-Coarse, becoming coarse SAND (SP)			
52	54	LAYERS V FINE SILTY SAND & MED-PINE SAND (SP-SM)			

7 CONTRACTOR'S OR LANDOWNER'S CERTIFICATION: This water well was (1) constructed, (2) reconstructed, or (3) plugged under my jurisdiction and was completed on (mo/day/year) MAY 3, 1994 and this record is true to the best of my knowledge and belief. Kansas Water Well Contractor's License No. 00007102 This Water Well Record was completed on (mo/day/yr) JULY 13, 1994 under the business name of \_\_\_\_\_ by (signature) Alan J. Harper

OFFICE USE ONLY  
T  
R  
EW  
SEC  
1/4  
1/4  
1/4