

1 LOCATION OF WATER WELL: Fraction SW 1/4 SW 1/4 SW 1/4 Section Number 27 Township Number T 10 S Range Number R 25 E  
 County: WYANDOTTE

Distance and direction from nearest town or city street address of well if located within city?

3126 BRINKERHOFF, K.C. KS 66115

WELL # MW-13B

2 WATER WELL OWNER: UNISON TRANSFORMER SERVICES

RR#, St. Address, Box #: 3126 BRINKERHOFF


Board of Agriculture, Division of Water Resources

City, State, ZIP Code: KANSAS CITY, KS 66115

Application Number:

3 LOCATE WELL'S LOCATION WITH AN "X" IN SECTION BOX:

4 DEPTH OF COMPLETED WELL: 49 ft. ELEVATION:

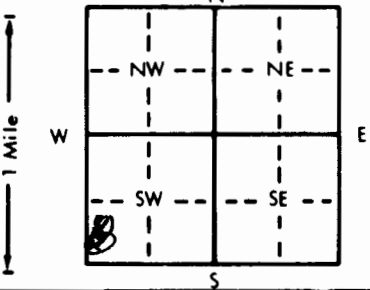

Depth(s) Groundwater Encountered 1. . . . . ft. 2. . . . . ft. 3. . . . . ft.  
 WELL'S STATIC WATER LEVEL 17.4 ft. below land surface measured on mo/day/yr 5/5/94  
 Pump test data: Well water was . . . . . ft. after . . . . . hours pumping . . . . . gpm  
 Est. Yield . . . . . gpm: Well water was . . . . . ft. after . . . . . hours pumping . . . . . gpm  
 Bore Hole Diameter: 8 in. to 5.4 in. and . . . . . in. to . . . . . in.  
 WELL WATER TO BE USED AS: 5 Public water supply 8 Air conditioning 11 Injection well  
 1 Domestic 3 Feedlot 6 Oil field water supply 9 Dewatering 12 Other (Specify below)  
 2 Irrigation 4 Industrial 7 Lawn and garden only 10 Monitoring well  
 Was a chemical/bacteriological sample submitted to Department? Yes . . . . . No X . . . . . If yes, mo/day/yr sample was submitted  
 Water Well Disinfected? Yes No X

5 TYPE OF BLANK CASING USED:

5 Wrought iron 8 Concrete tile CASING JOINTS: Glued . . . . . Clamped . . . . .

1 Steel 3 RMP (SR) 6 Asbestos-Cement 9 Other (specify below) Welded . . . . .  
2 PVC 4 ABS 7 Fiberglass . . . . . Threaded X

Blank casing diameter . . . . . 2 in. to 3.9 in. Dia . . . . . in. to . . . . . in. Dia . . . . . in. to . . . . . in.  
 Casing height above land surface . . . . . 0 in., weight . . . . . 0.70 lbs./ft. Wall thickness or gauge No. SCHED 40

TYPE OF SCREEN OR PERFORATION MATERIAL: 1 PVC 10 Asbestos-cement  
 1 Steel 3 Stainless steel 5 Fiberglass 8 RMP (SR) 11 Other (specify) . . . . .  
 2 Brass 4 Galvanized steel 6 Concrete tile 9 ABS 12 None used (open hole)

SCREEN OR PERFORATION OPENINGS ARE:  
 1 Continuous slot 3 Mill slot 01010 5 Gauzed wrapped 8 Saw cut 11 None (open hole)  
 2 Louvered shutter 4 Key punched 6 Wire wrapped 9 Drilled holes  
 7 Torch cut 10 Other (specify) . . . . .

SCREEN-PERFORATED INTERVALS: From 3.9 ft. to 4.9 ft., From . . . . . ft. to . . . . . ft.  
 From . . . . . ft. to . . . . . ft., From . . . . . ft. to . . . . . ft.  
 GRAVEL PACK INTERVALS: From 3.6 ft. to 4.9 ft., From . . . . . ft. to . . . . . ft.  
 From . . . . . ft. to . . . . . ft., From . . . . . ft. to . . . . . ft.

6 GROUT MATERIAL: 1 Neat cement 2 Cement grout 3 Bentonite 4 Other . . . . .

Grout Intervals: From 0 ft. to 33 ft., From 33 ft. to 36 ft., From . . . . . ft. to . . . . . ft.

What is the nearest source of possible contamination:  
 1 Septic tank 4 Lateral lines 7 Pit privy 10 Livestock pens 14 Abandoned water well  
 2 Sewer lines 5 Cess pool 8 Sewage lagoon 11 Fuel storage 15 Oil well/Gas well  
 3 Watertight sewer lines 6 Seepage pit 9 Feedyard 12 Fertilizer storage 16 Other (specify below)  
CLOSED INDUSTRIAL FACILITY

Direction from well? SOUTH How many feet? 10 FT

FROM	TO	LITHOLOGIC LOG	FROM	TO	PLUGGING INTERVALS
0	1	FILL			
1	3.5	DK BRWN CLY SLT (ML)			
3.5	9.5	MIXED LOW PLASTIC SILTY CLY & CLY SLT (ML&CL)			
9.5	10.5	LT BRWN V FINE SILTY SND (SM)			
10.5	14	V FINE SILTY SAND W/ SANDY SILT (SM w ML)			
14	19	LT BRWN V FINE SILTY SND (SM)			
19	21	FINE SAND (SP)			
21	29	FINE-MED SAND W/ TR SILTY SND (SP w SM)			
29	42	MED I/M SAND W/ SOME COARSE (SP)			
42	47	V FINE SILTY SAND - SANDY SILT (SM)			
47	52	MED - COARSE, BECOMING COARSE SAND (SP)			
52	54	LAYERED V FINE SILTY SAND & MED - FINE SAND (SP - SM)			

7 CONTRACTOR'S OR LANDOWNER'S CERTIFICATION: This water well was (1) constructed, (2) reconstructed, or (3) plugged under my jurisdiction and was completed on (mo/day/year) MAY 3, 1994 and this record is true to the best of my knowledge and belief. Kansas Water Well Contractor's License No. AD0057 102 This Water Well Record was completed on (mo/day/yr) JULY 13, 1994 under the business name of \_\_\_\_\_ by (signature) [Signature]