


1 LOCATION OF WATER WELL: Fraction SW 1/4 SW 1/4 SW 1/4 Section Number 27 Township Number T 10 S Range Number R 25 E
 County: WYANDOTTE

Distance and direction from nearest town or city street address of well if located within city?
3126 BRINKERHOFF RD, K.C. MO 66115 WELL # MW 12A

2 WATER WELL OWNER: UNISON TRANSFORMER SERVICES
 RR#, St. Address, Box #: 3126 BRINKERHOFF RD Board of Agriculture, Division of Water Resources
 City, State, ZIP Code: KANSAS CITY, KANSAS 66115 Application Number:

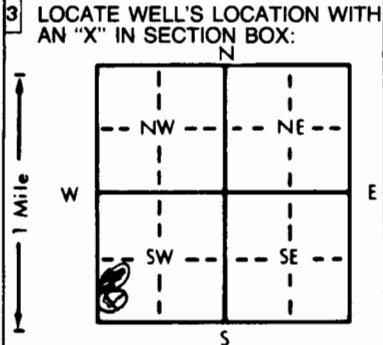

4 DEPTH OF COMPLETED WELL: 30 ft. ELEVATION:
 Depth(s) Groundwater Encountered 1. ft. 2. ft. 3. ft.
 WELL'S STATIC WATER LEVEL 17.2 ft. below land surface measured on mo/day/yr 5/5/94
 Pump test data: Well water was ft. after hours pumping gpm
 Est. Yield gpm: Well water was ft. after hours pumping gpm
 Bore Hole Diameter: 8 in. to 3.3 ft., and in. to ft.
 WELL WATER TO BE USED AS:
 5 Public water supply 8 Air conditioning 11 Injection well
 1 Domestic 3 Feedlot 6 Oil field water supply 9 Dewatering 12 Other (Specify below)
 2 Irrigation 4 Industrial 7 Lawn and garden only 10 Monitoring well
 Was a chemical/bacteriological sample submitted to Department? Yes No X; If yes, mo/day/yr sample was submitted
 Water Well Disinfected? Yes No X

5 TYPE OF BLANK CASING USED:
 1 Steel 3 RMP (SR) 5 Wrought iron 8 Concrete tile CASING JOINTS: Glued Clamped
2 PVC 4 ABS 6 Asbestos-Cement 9 Other (specify below) Welded
 7 Fiberglass Threaded X
 Blank casing diameter 2 in. to 20 ft., Dia in. to ft., Dia in. to ft.
 Casing height above land surface 60 in., weight 0.70 lbs./ft. Wall thickness or gauge No. SCMO 40
 TYPE OF SCREEN OR PERFORATION MATERIAL: 7 PVC 10 Asbestos-cement
 1 Steel 3 Stainless steel 5 Fiberglass 8 RMP (SR) 11 Other (specify)
 2 Brass 4 Galvanized steel 6 Concrete tile 9 ABS 12 None used (open hole)
 SCREEN OR PERFORATION OPENINGS ARE:
 1 Continuous slot 3 Mill slot 10-SLOT 5 Gauzed wrapped 8 Saw cut 11 None (open hole)
 2 Louvered shutter 4 Key punched 6 Wire wrapped 9 Drilled holes
 7 Torch cut 10 Other (specify)
 SCREEN-PERFORATED INTERVALS: From 20 ft. to 30 ft., From ft. to ft.
 From ft. to ft., From ft. to ft.
 GRAVEL PACK INTERVALS: From 18 ft. to 30 ft., From ft. to ft.
 From ft. to ft., From ft. to ft.

6 GROUT MATERIAL: 1 Neat cement 2 Cement grout 3 Bentonite 4 Other
 Grout Intervals: From 0 ft. to 15 ft., From 15 ft. to 18 ft., From ft. to ft.
 What is the nearest source of possible contamination:
 1 Septic tank 4 Lateral lines 7 Pit privy 10 Livestock pens 14 Abandoned water well
 2 Sewer lines 5 Cess pool 8 Sewage lagoon 11 Fuel storage 15 Oil well/Gas well
 3 Watertight sewer lines 6 Seepage pit 9 Feedyard 12 Fertilizer storage 16 Other (specify below)
CLOSED INDUST. FACILITY
 Direction from well? WEST How many feet? 40 FT

FROM	TO	LITHOLOGIC LOG	FROM	TO	PLUGGING INTERVALS
0	15	FILL			
15	5	LT BRN LOW PLASTIC CLAYEY SILT (ML)			
5	6.5	MIXED LOW PLASTIC SILT & CLS (ML-CL)			
6.5	8	LOW PLASTIC SILTY CLAY (CL)			
8	15	LOW PLASTIC CLAYEY SILT (ML)			
15	17	LT BRN V FINE SILTY SAND (SM)			
17	20	V FINE SILTY SAND W/ SILT LAYERS (SM/ML)			
20	22.5	LOW PLASTIC SILT (ML)			
22.5	29	SANDY SILT TO V FINE SILTY SAND (SM)			
29	41	FINE SAND W/ V FINE SILTY SAND (SP w/ SM)			
41	53	MED SAND, POORLY GRADED W/ TR COARSE SAND & FINE GUL (SP)			
53	54	FINE-MED SAND W/ SOME LAYERS OF SILTY SAND & TR CLAY (SP w/ SM)			

7 CONTRACTOR'S OR LANDOWNER'S CERTIFICATION: This water well was (1) constructed, (2) reconstructed, or (3) plugged under my jurisdiction and was completed on (mo/day/year) MAY 4, 1994 and this record is true to the best of my knowledge and belief. Kansas Water Well Contractor's License No. AD0057 102 This Water Well Record was completed on (mo/day/yr) JUN 13, 1994 under the business name of _____ by (signature) [Signature]

OFFICE USE ONLY
T
R
EW
SEC.
1/4
1/4
1/4