


1 LOCATION OF WATER WELL: County: **CLAY** Fraction: **NE 1/4 NE 1/4 NW 1/4** Section Number: **19** Township Number: **T 10 S** Range Number: **R 3 E/W**

Distance and direction from nearest town or city street address of well if located within city?
12.0 MILES SOUTH OF CLAY CENTER KS

2 WATER WELL OWNER: **OREN MILLER**
 RR#, St. Address, Box #: **2211 STARDUST DR.** Board of Agriculture, Division of Water Resources
 City, State, ZIP Code: **CLAY CENTER KS 67432** Application Number:

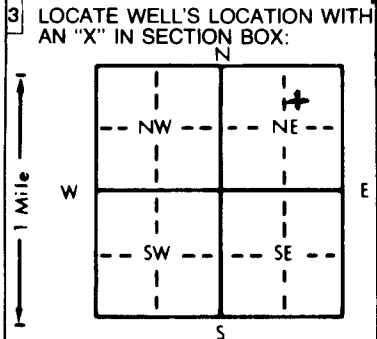

4 DEPTH OF COMPLETED WELL: **83** ft. ELEVATION:
 Depth(s) Groundwater Encountered 1. ft. 2. ft. 3. ft.
 WELL'S STATIC WATER LEVEL: **62** ft. below land surface measured on mo/day/yr **5-7-99**
 Pump test data: Well water was ft. after hours pumping gpm
 Est. Yield gpm: Well water was ft. after hours pumping gpm
 Bore Hole Diameter in. to ft., and in. to ft.
 WELL WATER TO BE USED AS:
 1 Domestic 3 Feedlot 6 Oil field water supply 9 Dewatering 12 Other (Specify below)
 2 Irrigation 4 Industrial 7 Lawn and garden only 10 Monitoring well
 Was a chemical/bacteriological sample submitted to Department? Yes No If yes, mo/day/yr sample was submitted
 Water Well Disinfected? Yes No

5 TYPE OF BLANK CASING USED:
 1 Steel 3 RMP (SR) 6 Asbestos-Cement 9 Other (specify below) Welded
 2 PVC 4 ABS 7 Fiberglass Threaded
 Blank casing diameter: **5** in. to ft., Dia in. to ft., Dia in. to ft.
 Casing height above land surface: **3 FT. BELOW** weight lbs./ft. Wall thickness or gauge No.
 TYPE OF SCREEN OR PERFORATION MATERIAL:
 1 Steel 3 Stainless steel 5 Fiberglass 8 RMP (SR) 11 Other (specify)
 2 Brass 4 Galvanized steel 6 Concrete tile 9 ABS 12 None used (open hole)
 SCREEN OR PERFORATION OPENINGS ARE:
 1 Continuous slot 3 Mill slot 6 Wire wrapped 9 Drilled holes
 2 Louvered shutter 4 Key punched 7 Torch cut 10 Other (specify)
 SCREEN-PERFORATED INTERVALS: From ft. to ft., From ft. to ft.
 GRAVEL PACK INTERVALS: From ft. to ft., From ft. to ft.
PLUG

6 GROUT MATERIAL: 1 Neat cement 2 Cement grout 3 Bentonite 4 Other
 Grout Intervals: From ft. to ft., From ft. to ft., From ft. to ft.
 What is the nearest source of possible contamination:
 1 Septic tank 4 Lateral lines 7 Pit privy 10 Livestock pens 14 Abandoned water well
 2 Sewer lines 5 Cess pool 8 Sewage lagoon 11 Fuel storage 15 Oil well/Gas well
 3 Watertight sewer lines 6 Seepage pit 9 Feedyard 12 Fertilizer storage 16 Other (specify below)
 13 Insecticide storage
 Direction from well? **SOUTH** How many feet? **20 FT**

FROM	TO	LITHOLOGIC LOG	FROM	TO	PLUGGING INTERVALS
83	62	SAND & GRAVEL (2.94 CU FT)			
62	6	CLAY (7.84 CU FT)			
6	3	BENTONITE (.5 CU FT)			
		PLUS 3 50* BAGS FOR MUSHROOM)			

7 CONTRACTOR'S OR LANDOWNER'S CERTIFICATION: This water well was (1) constructed, (2) reconstructed, or (3) plugged under my jurisdiction and was completed on (mo/day/year) **5-7-99** and this record is true to the best of my knowledge and belief. Kansas Water Well Contractor's License No. **647** This Water Well Record was completed on (mo/day/yr) **5-10-99** under the business name of **MEL'S PUMP & PLUMBING** by (signature) *Melvin M Anderson*

OFFICE USE ONLY
T
R
EW
SEC
1/4
1/4