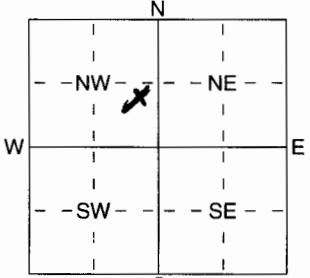


1 LOCATION OF WATER WELL: Fraction NE 1/4 SE 1/4 NW 1/4 Section Number 34 Township Number T 18 S Range Number R 3 E  
 County: Holden Co.  
 Distance and direction from nearest town or city street address of well if located within city? From Wakefield 6.6 miles west on 83 Hwy to 15 Hwy 6.0 south 5 miles + 2 1/4 East + 1/4 South

2 WATER WELL OWNER: Bruce Warner  
 RR#, St. Address, Box #: P.O. Box 2268 Board of Agriculture, Division of Water Resources  
 City, State, ZIP Code: Salina, KS 67402 Application Number:

3 LOCATE WELL'S LOCATION WITH AN "X" IN SECTION BOX:  4 DEPTH OF COMPLETED WELL ..... 195 ..... ft. ELEVATION: .....  
 Depth(s) Groundwater Encountered 1. 136 ..... ft. 2 ..... ft. 3 ..... ft.  
 WELL'S STATIC WATER LEVEL ..... 130 ..... ft. below land surface measured on mo/day/yr .....  
 Pump test data: Well water was ..... ft. after ..... hours pumping ..... gpm  
 Est. Yield ..... 25.7 ..... gpm: Well water was ..... ft. after ..... hours pumping ..... gpm  
 WELL WATER TO BE USED AS: 5 Public water supply 8 Air conditioning 11 Injection well  
 1 Domestic 3 Feedlot 6 Oil field water supply 9 Dewatering 12 Other (Specify below)  
 2 Irrigation 4 Industrial 7 Domestic (lawn & garden) 10 Monitoring well .....  
 Was a chemical/bacteriological sample submitted to Department? Yes ..... No .....; If yes, mo/day/yr sample was submitted  
 Water Well Disinfected? Yes No

5 TYPE OF BLANK CASING USED: 5 Wrought iron 8 Concrete tile CASING JOINTS Glued Clamped .....  
 1 Steel 3 RMP (SR) 6 Asbestos-Cement 9 Other (specify below) Welded  
2 PVC 4 ABS 7 Fiberglass Threaded .....  
 Blank casing diameter ..... 5 1/2 in. to 17.5 ft. Dia ..... in. to ..... ft. Dia ..... in. to ..... ft.  
 Casing height above land surface ..... 2' in. weight Sch. 40 lbs./ft. Wall thickness or gauge No. ....  
 TYPE OF SCREEN OR PERFORATION MATERIAL: PVC 10 Asbestos-Cement  
 1 Steel 3 Stainless Steel 5 Fiberglass 8 RMP (SR) 11 Other (Specify) .....  
 2 Brass 4 Galvanized Steel 6 Concrete tile 9 ABS 12 None used (open hole) .....  
 SCREEN OR PERFORATION OPENINGS ARE: 3-Mill slot 25/1000 5 Gauzed wrapped 8 Saw cut 11 None (open hole)  
 1 Continuous slot 2 Louvered shutter 4 Key punched 6 Wire wrapped 9 Drilled holes 10 Other (specify) ..... ft.  
 SCREEN-PERFORATED INTERVALS: From ..... 17.5 ..... ft. to 19.5 ..... ft. From ..... ft. to ..... ft.  
 GRAVEL PACK INTERVALS: From ..... 2.5 ..... ft. to 19.5 ..... ft. From ..... ft. to ..... ft.

6 GROUT MATERIAL: 1 Neat cement 2 Cement grout 3 Bentonite 4 Other .....  
 Grout Intervals: From ..... 5 ..... ft. to 2.5 ..... ft. From ..... ft. to ..... ft. From ..... ft. to ..... ft.  
 What is the nearest source of possible contamination: None Close  
 1 Septic tank 4 Lateral lines 8 Pit privy 10 Livestock pens 14 Abandoned water well  
 2 Sewer lines 5 Cess pool 8 Sewage lagoon 11 Fuel storage 15 Oil well/Gas well  
 3 Watertight sewer lines 6 Seepage pit 9 Feedyard 12 Fertilizer storage 16 Other (specify below)  
 13 Insecticide storage .....  
 Direction from well? How many feet?

FROM	TO	LITHOLOGIC LOG	FROM	TO	PLUGGING INTERVALS
0	1	Top Soil			
1	5	Brown Clay			
5	56	Yellow Clay			
56	58	Brown Shale			
58	63	Limestone			
63	84	Brown Shale			
84	90	Limestone			
90	111	Brown Shale			
111	129	Limestone			
129	131	Brown Shale			
131	160	Limestone (Water)			
160	175	Brown Shale			
175	190	Limestone			
190	195	Grey Shale			

RECEIVED  
 AUG 27 2004  
 BUREAU OF WATER

7 CONTRACTOR'S OR LANDOWNER'S CERTIFICATION: This water well was (1) constructed, (2) reconstructed, or (3) plugged under my jurisdiction and was completed on (mo/day/year) ..... 8/25/2004 ..... and this record is true to the best of my knowledge and belief. Kansas Water Well Contractor's Licence No ..... 451 ..... This Water Well Record was completed on (mo/day/yr) ..... 8/25/2004 ..... under the business name of Holdeman Well Drilling by (signature) Craig M. Cuppe