

**WATER WELL RECORD Form WWC-5**


Original Record  Correction  Change in Well Use

Division of Water Resources App. No.  

Well ID  

**1 LOCATION OF WATER WELL:** County: CLAY Fraction: NW 1/4 NW 1/4 NE 1/4 Section Number: 34 Township Number: T 10 S Range Number: R 3 E

**2 WELL OWNER:** Last Name: MILLER First: Samuel Street or Rural Address where well is located (if unknown, distance and direction from nearest town or intersection): If at owner's address, check here:   
 Business: 1662 2nd Rd From Waterfield Go West 2 miles on 82 to  
 Address: WAKEFIELD QUAIL Rd Go South 5 miles to 2nd Rd. Then West  
 City: WAKEFIELD State: KS ZIP: 67487 1/2 mile

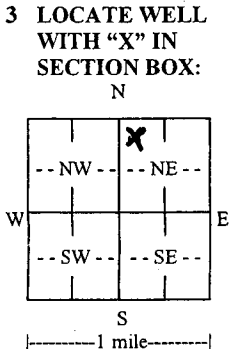

**4 DEPTH OF COMPLETED WELL:** 160' ft.  
 Depth(s) Groundwater Encountered: 1) 132 ft.  
 2) ..... ft. 3) ..... ft., or 4)  Dry Well  
 WELL'S STATIC WATER LEVEL: 10.0 ft.  
 below land surface, measured on (mo-day-yr) 4/15/2022  
 above land surface, measured on (mo-day-yr) .....  
 Pump test data: Well water was ..... ft.  
 after ..... hours pumping ..... gpm  
 Well water was ..... ft.  
 after ..... hours pumping ..... gpm  
 Estimated Yield: 20 gpm  
 Bore Hole Diameter: 9" in. to 160' ft. and  
 ..... in. to ..... ft.

**5 Latitude:** N. 39° 08.840 (decimal degrees)  
**Longitude:** W. 097° 04.839 (decimal degrees)  
 Horizontal Datum:  WGS 84  NAD 83  NAD 27  
 Source for Latitude/Longitude:  GPS (unit make/model: SAMMIN E TOPX 20)  
 (WAAS enabled?  Yes  No)  
 Land Survey  Topographic Map  
 Online Mapper: .....

**6 Elevation:** 1305 ft.  Ground Level  TOC  
 Source:  Land Survey  GPS  Topographic Map  
 Other .....

**7 WELL WATER TO BE USED AS:**

1.  Domestic:  Household  Lawn & Garden  Livestock  
 2.  Irrigation  
 3.  Feedlot  
 4.  Industrial

5.  Public Water Supply: well ID .....

6.  Dewatering: how many wells? .....

7.  Aquifer Recharge: well ID .....

8.  Monitoring: well ID .....

9. Environmental Remediation: well ID .....

Air Sparge  Soil Vapor Extraction  
 Recovery  Injection

10.  Oil Field Water Supply: lease .....

11. Test Hole: well ID .....

Cased  Uncased  Geotechnical

12. Geothermal: how many bores? .....

a) Closed Loop  Horizontal  Vertical  
 b) Open Loop  Surface Discharge  Inj. of Water

13.  Other (specify): .....

Was a chemical/bacteriological sample submitted to KDHE?  Yes  No If yes, date sample was submitted: .....

Water well disinfected?  Yes  No

**8 TYPE OF CASING USED:**  Steel  PVC  Other ..... CASING JOINTS:  Glued  Clamped  Welded  Threaded  
 Casing diameter 5" in. to 140' ft., Diameter ..... in. to ..... ft., Diameter ..... in. to ..... ft.  
 Casing height above land surface 2' in. Weight 500 lbs./ft. Wall thickness or gauge No. ....  
**TYPE OF SCREEN OR PERFORATION MATERIAL:**  
 Steel  Stainless Steel  Fiberglass  PVC  Other (Specify) .....  
 Brass  Galvanized Steel  Concrete tile  None used (open hole)  
**SCREEN OR PERFORATION OPENINGS ARE:**  
 Continuous Slot  Mill Slot  Gauze Wrapped  Torch Cut  Drilled Holes  Other (Specify) .....  
 Louvered Shutter  Key Punched  Wire Wrapped  Saw Cut  None (Open Hole)  
**SCREEN-PERFORATED INTERVALS:** From 135 ft. to 155 ft., From ..... ft. to ..... ft.  
**GRAVEL PACK INTERVALS:** From 25 ft. to 155 ft., From ..... ft. to ..... ft., From ..... ft. to ..... ft.

**9 GROUT MATERIAL:**  Neat cement  Cement grout  Bentonite  Other .....  
 Grout Intervals: From 5 ft. to 25 ft., From ..... ft. to ..... ft., From ..... ft. to ..... ft.  
**Nearest source of possible contamination:** None Close  
 Septic Tank  Lateral Lines  Pit Privy  Livestock Pens  Insecticide Storage  
 Sewer Lines  Cess Pool  Sewage Lagoon  Fuel Storage  Abandoned Water Well  
 Watertight Sewer Lines  Seepage Pit  Feedyard  Fertilizer Storage  Oil Well/Gas Well  
 Other (Specify) .....

Direction from well? ..... Distance from well? ..... ft.

10 FROM	TO	LITHOLOGIC LOG	FROM	TO	LITHO. LOG (cont.) or PLUGGING INTERVALS
0	1	Top Soil	132	154	Limestone (WATIN)
1	27	Brown Clay	154	160	Grey Shale
27	38	Limestone			
38	50	Brown Shale			
50	51	Limestone			
51	68	Brown Shale			
68	97	Yellow Shale			
97	101	Limestone			
101	132	Brown Shale			

Notes: .....

**11 CONTRACTOR'S OR LANDOWNER'S CERTIFICATION:** This water well was  constructed,  reconstructed, or  plugged under my jurisdiction and was completed on (mo-day-year) 6/15/2022 and this record is true to the best of my knowledge and belief.  
 Kansas Water Well Contractor's License No. 451 This Water Well Record was completed on (mo-day-year) 6/19/2022  
 under the business name of Haldeman Well Drilling Craig M. Gault

Mail 1 white copy along with a fee of \$5.00 for each constructed well to: Kansas Department of Health and Environment, Bureau of Water, GWA's Section, 1000 SW Jackson St., Suite 420, Topeka, Kansas 66612-1367. Mail one to Water Well Owner and retain one for your records. Telephone 785-296-5524.