


1 LOCATION OF WATER WELL: County: **CLAY** Fraction: **NE 1/4 NW 1/4 NW 1/4** Section Number: **7** Township Number: **T 10 S** Range Number: **R 3 E E/W**

Distance and direction from nearest town or city street address of well if located within city?
From Wakefield - 6 miles W. on Hwy. #82, 1 mile South, and 3/4 mile West

2 WATER WELL OWNER: **Horace Case**
 RR#, St. Address, Box #: **Route 2** Board of Agriculture, Division of Water Resources
 City, State, ZIP Code: **Wakefield, Kansas 67487** Application Number:

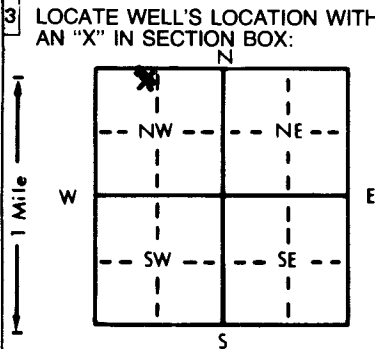

4 DEPTH OF COMPLETED WELL: **100'** ft. ELEVATION:
 Depth(s) Groundwater Encountered 1. **95'** ft. 2. _____ ft. 3. _____ ft.
 WELL'S STATIC WATER LEVEL: **90'** ft. below land surface measured on **6-23-83** mo/day/yr
 Pump test data: Well water was **100'** ft. after **3/4** hours pumping **12** gpm
 Est. Yield **12** gpm: Well water was _____ ft. after _____ hours pumping _____ gpm
 Bore Hole Diameter: **8"** in. to **100'** ft., and _____ in. to _____ ft.
 WELL WATER TO BE USED AS: 5 Public water supply 8 Air conditioning 11 Injection well
 X1 Domestic 3 Feedlot 6 Oil field water supply 9 Dewatering 12 Other (Specify below)
 2 Irrigation 4 Industrial 7 Lawn and garden only 10 Observation well
 Was a chemical/bacteriological sample submitted to Department? Yes _____ No **X**; If yes, mo/day/yr sample was submitted
 Water Well Disinfected? Yes **X** No

5 TYPE OF BLANK CASING USED: 5 Wrought iron 8 Concrete tile CASING JOINTS: Glued **X** Clamped _____
 1 Steel 3 RMP (SR) 6 Asbestos-Cement 9 Other (specify below) Welded _____
 X 2 PVC 4 ABS 7 Fiberglass _____ Threaded _____
 Blank casing diameter **5"** in. to **80'** ft., Dia _____ in. to _____ ft., Dia _____ in. to _____ ft.
 Casing height above land surface: **12"** in., weight **3** lbs./ft. Wall thickness or gauge No. **.258**

TYPE OF SCREEN OR PERFORATION MATERIAL: X 7 PVC 10 Asbestos-cement
 1 Steel 3 Stainless steel 5 Fiberglass 8 RMP (SR) 11 Other (specify) _____
 2 Brass 4 Galvanized steel 6 Concrete tile 9 ABS 12 None used (open hole)
 SCREEN OR PERFORATION OPENINGS ARE: 5 Gauzed wrapped X 8 Saw cut 11 None (open hole)
 1 Continuous slot 3 Mill slot 6 Wire wrapped 9 Drilled holes
 2 Louvered shutter 4 Key punched 7 Torch cut 10 Other (specify) _____
 SCREEN-PERFORATED INTERVALS: From **80** ft. to **100** ft., From _____ ft. to _____ ft.
 From _____ ft. to _____ ft., From _____ ft. to _____ ft.
 GRAVEL PACK INTERVALS: From **20** ft. to **100** ft., From _____ ft. to _____ ft.
 From _____ ft. to _____ ft., From _____ ft. to _____ ft.

6 GROUT MATERIAL: 1 Neat cement 2 Cement grout X3 Bentonite 4 Other _____
 Grout Intervals: From **4** ft. to **20** ft., From _____ ft. to _____ ft., From _____ ft. to _____ ft.
 What is the nearest source of possible contamination: **NONE** 10 Livestock pens 14 Abandoned water well
 1 Septic tank 4 Lateral lines 7 Pit privy 11 Fuel storage 15 Oil well/Gas well
 2 Sewer lines 5 Cess pool 8 Sewage lagoon 12 Fertilizer storage 16 Other (specify below)
 3 Watertight sewer lines 6 Seepage pit 9 Feedyard 13 Insecticide storage _____

Direction from well? How many feet?

FROM	TO	LITHOLOGIC LOG	FROM	TO	LITHOLOGIC LOG
0	3	Top Soil & Clay			
3	76	Yellow Clay			
76	82	Red Clay			
82	85	Yellow Clay			
85	89	Gray Clay			
89	95	Yellow Clay			
95	100	Sandrock			
100		Shale			

7 CONTRACTOR'S OR LANDOWNER'S CERTIFICATION: This water well was (1) constructed, (2) reconstructed, or (3) plugged under my jurisdiction and was completed on (mo/day/year) **June 23, 1983** and this record is true to the best of my knowledge and belief. Kansas Water Well Contractor's License No. **361** This Water Well Record was completed on (mo/day/yr) **June 23, 1983** under the business name of **Cox-Beswick Irrigation Service, Inc.** by (signature) *Francis Cox*

INSTRUCTIONS: Use typewriter or ball point pen, PLEASE PRESS FIRMLY and PRINT clearly. Please fill in blanks, underline or circle the correct answers. Send top three copies to Kansas Department of Health and Environment, Division of Environment, Environmental Geology Section, Topeka, KS 66620. Send one to WATER WELL OWNER and retain one for your records.

OFFICE USE ONLY
T
10
R
3
EW
SEC
7
NE 1/4 NW 1/4 NW 1/4