


1 LOCATION OF WATER WELL: County: Clay Fraction: SE 1/4 SE 1/4 SE 1/4 Section Number: 19 Township Number: T 10 S Range Number: R 3 EW

Distance and direction from nearest town or city street address of well if located within city?

2 WATER WELL OWNER: Harvey Davidson  
 RR#, St. Address, Box #: 313 Navajo Rd Board of Agriculture, Division of Water Resources  
 City, State, ZIP Code: Wakefield, KS 67487 Application Number:

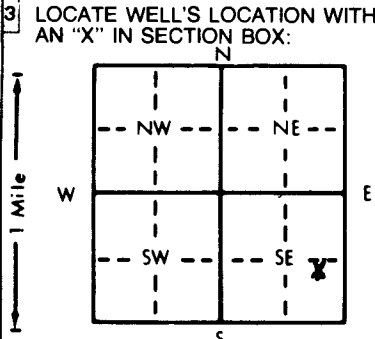

4 DEPTH OF COMPLETED WELL: 83 ft. ELEVATION:  
 Depth(s) Groundwater Encountered 1. 64 ft. 2. ft. 3. ft.  
 WELL'S STATIC WATER LEVEL: 64 ft. below land surface measured on mo/day/yr  
 Pump test data: Well water was ft. after hours pumping gpm  
 Est. Yield gpm: Well water was ft. after hours pumping gpm  
 Bore Hole Diameter in. to ft., and in. to ft.  
 WELL WATER TO BE USED AS:  
 1 Domestic  2 Irrigation  3 Feedlot  4 Industrial  5 Public water supply  6 Oil field water supply  7 Lawn and garden only  8 Air conditioning  9 Dewatering  10 Monitoring well  11 Injection well  12 Other (Specify below)  
 Was a chemical/bacteriological sample submitted to Department? Yes No  X; If yes, mo/day/yr sample was submitted  
 Water Well Disinfected? Yes  X No

5 TYPE OF BLANK CASING USED:  
 1 Steel  2 PVC  3 RMP (SR)  4 ABS  5 Wrought iron  6 Asbestos-Cement  7 Fiberglass  8 Concrete tile  9 Other (specify below)  
 Blank casing diameter 4 in. to ft., Dia. in. to ft., Dia. in. to ft.  
 Casing height above land surface 56 in., weight lbs./ft. Wall thickness or gauge No.  
 TYPE OF SCREEN OR PERFORATION MATERIAL:  
 1 Steel  2 Brass  3 Stainless steel  4 Galvanized steel  5 Fiberglass  6 Concrete tile  7 PVC  8 RMP (SR)  9 ABS  10 Asbestos-cement  11 Other (specify) N/A  12 None used (open hole)  
 SCREEN OR PERFORATION OPENINGS ARE:  
 1 Continuous slot  2 Louvered shutter  3 Mill slot  4 Key punched  5 Gauzed wrapped  6 Wire wrapped  7 Torch cut  8 Saw cut  9 Drilled holes  10 Other (specify) N/A  11 None (open hole)  
 SCREEN-PERFORATED INTERVALS: gravel From 1 ft. to 64 ft. From N/A ft. to N/A ft.  
clay From 1 ft. to 5 ft. From N/A ft. to N/A ft.  
 GRAVEL PACK INTERVALS: Bentonite From 5 ft. to 4.5 ft. From N/A ft. to N/A ft.  
Topsoil From 4.5 ft. to 5 ft. From N/A ft. to N/A ft.

6 GROUT MATERIAL:  1 Neat cement  2 Cement grout  3 Bentonite  4 Other  
 Grout Intervals: From 5 ft. to 4.5 ft., From ft. to ft., From ft. to ft.  
 What is the nearest source of possible contamination:  
 1 Septic tank  2 Sewer lines  3 Watertight sewer lines  4 Lateral lines  5 Cess pool  6 Seepage pit  7 Pit privy  8 Sewage lagoon  9 Feedyard  10 Livestock pens  11 Fuel storage  12 Fertilizer storage  13 Insecticide storage  14 Abandoned water well  15 Oil well/Gas well  16 Other (specify below) NONE APPARENT

Direction from well? How many feet?

| FROM | TO | LITHOLOGIC LOG | FROM       | TO         | PLUGGING INTERVALS |
|------|----|----------------|------------|------------|--------------------|
|      |    |                | <u>83</u>  | <u>64</u>  | <u>gravel</u>      |
|      |    |                | <u>64</u>  | <u>5</u>   | <u>clay</u>        |
|      |    |                | <u>5</u>   | <u>4.5</u> | <u>Bentonite</u>   |
|      |    |                | <u>4.5</u> | <u>0</u>   | <u>Top Soil</u>    |

7 CONTRACTOR'S OR LANDOWNER'S CERTIFICATION: This water well was (1) constructed, (2) reconstructed, or (3) plugged under my jurisdiction and was completed on (mo/day/year) Jan 4, 1994 and this record is true to the best of my knowledge and belief. Kansas Water Well Contractor's License No. This Water Well Record was completed on (mo/day/yr) Jan 4, 1994 under the business name of by (signature) Ronald G. Gilbert

INSTRUCTIONS: Use typewriter or ball point pen. PLEASE PRESS FIRMLY and PRINT clearly. Please fill in blanks, underline or circle the correct answers. Send top three copies to Kansas Department of Health and Environment, Bureau of Water, Topeka, Kansas 66620-0001. Telephone: 913-296-5545. Send one to WATER WELL OWNER and retain one for your records.