

USE TYPEWRITER OR BALL POINT PEN-PRESS FIRMLY, PRINT CLEARLY.


WATER WELL RECORD  
KSA 82a-1201-1215

Kansas Department of Health and Environment-Division of Environment  
(Water well Contractors)  
Topeka, Kansas 66620

NE 1/4 NE 1/4 SW 1/4

1. Location of well:	County <b>Clay</b>	Fraction <b>NE 1/4 NW 1/4 SW 1/4</b>	Section number <b>29</b>	Township number <b>T 10 S R 3</b>	Range number <b>E/W</b>
----------------------	-----------------------	---	-----------------------------	--------------------------------------	----------------------------

2. Distance and direction from nearest town or city: <b>3 mi east of Industry KS</b> Street address of well location if in city: <b>1/2 north east side of Road</b>	3. Owner of well: <b>Allen Holt</b> R.R. or street: <b>R R</b> City, state, zip code: <b>Wakefield Kans 67487</b>
--	--

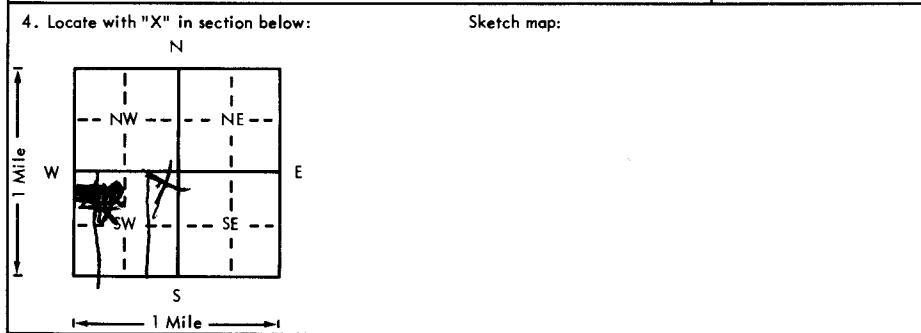

5. Type and color of material	From	To
top soil, Black	0	15
Rock, yellow lime	15	25
Clay, yellow hard	25	37
Rock, Lime yellow Porous (water)	37	52
S shale, Blue hard	52	70
(Use a second sheet if needed)		

6. Bore hole dia. <b>1 1/4</b> in. Completion date Well depth <b>70</b> ft. <b>1-7-78</b>
7. <input checked="" type="checkbox"/> Cable tool <input type="checkbox"/> Rotary <input type="checkbox"/> Driven <input type="checkbox"/> Dug <input type="checkbox"/> Hollow rod <input type="checkbox"/> Jetted <input type="checkbox"/> Bored <input type="checkbox"/> Reverse rotary
8. Use: <input type="checkbox"/> Domestic <input type="checkbox"/> Public supply <input type="checkbox"/> Industry <input checked="" type="checkbox"/> Irrigation <input type="checkbox"/> Air conditioning <input type="checkbox"/> Stock <input type="checkbox"/> Lawn <input type="checkbox"/> Oil field water <input type="checkbox"/> Other
<input checked="" type="checkbox"/> Casing: Material <b>PVC</b> Height: Above or below Threaded <input type="checkbox"/> Welded <input type="checkbox"/> Surface <b>7 1/2</b> in. RMP <input type="checkbox"/> PVC <input checked="" type="checkbox"/> Weight <input type="checkbox"/> lbs./ft. Dia. <b>5</b> in. to <b>70</b> ft. depth Wall Thickness: inches <b>2 1/8</b> Dia. <input type="checkbox"/> in. to <input type="checkbox"/> ft. depth gage No. <b>11</b>
10. Screen: Manufacturer's name <b>M.P.I.</b> Type <b>P.V.C.</b> Dia. <b>3 1/2</b> Slot/gauge <input type="checkbox"/> Length <b>30</b> Set between <b>70</b> ft. and <b>40</b> ft. <input type="checkbox"/> ft. and <input type="checkbox"/> ft. Gravel pack? <input checked="" type="checkbox"/> Size range of material <b>8 X 4</b>
11. Static water level: <input type="checkbox"/> mo./day/yr. <b>40</b> ft. below land surface Date <b>1-7-78</b>
12. Pumping level below land surfaces: <input type="checkbox"/> ft. after <input type="checkbox"/> hrs. pumping <input type="checkbox"/> g.p.m. <input type="checkbox"/> ft. after <input type="checkbox"/> hrs. pumping <input type="checkbox"/> g.p.m. Estimated maximum yield <b>30</b> g.p.m.
13. Water sample submitted: <input type="checkbox"/> mo./day/yr. Yes <input checked="" type="checkbox"/> No <input type="checkbox"/> Date
14. Well head completion: <b>NA</b> <input type="checkbox"/> Pitless adapter <input type="checkbox"/> inches above grade
15. Well grouted? <input checked="" type="checkbox"/> <b>1 1/2</b> With: <input type="checkbox"/> Neat cement <input type="checkbox"/> Bentonite <input checked="" type="checkbox"/> Concrete Depth: From <b>16</b> ft. to <b>5</b> ft.
16. Nearest source of possible contamination: ft. <b>100</b> Direction <b>south</b> Type <b>cow lot</b> Well disinfected upon completion? <input checked="" type="checkbox"/> Yes <input type="checkbox"/> No
17. Pump: <input checked="" type="checkbox"/> Not installed Manufacturer's name _____ Model number _____ HP _____ Volts _____ Length of drop pipe _____ ft. capacity _____ g.p.m. Type: <input type="checkbox"/> Submersible <input type="checkbox"/> Turbine <input type="checkbox"/> Jet <input type="checkbox"/> Reciprocating <input type="checkbox"/> Centrifugal <input type="checkbox"/> Other

18. Elevation:

Topography:  
 Hill  
 Slope  
 Upland  
 Valley

19. Remarks:

20. Water well contractor's certification:  
This well was drilled under my jurisdiction and this report is true to the best of my knowledge and belief.  
**Strader Drilling Co 237**  
Business name \_\_\_\_\_ License No. \_\_\_\_\_  
Address **Blue Rapids**  
Signed **Harold Strader** Date **1-7**  
Authorized representative

1-7-78  
29  
W  
29  
NE  
SW