


WATER WELL RECORD Form WWC-5 KSA 82a-1212

1 LOCATION OF WATER WELL: Fraction NE 1/4 NE 1/4 NE 1/4 Section Number 35 Township Number T 10 S Range Number R 3 E

Distance and direction from nearest town or city street address of well if located within city?  
1 West, 4 South of Wakefield

2 WATER WELL OWNER: Milton Keim  
RR#, St. Address, Box #: Route 1 Wakefield, Kansas 67487  
City, State, ZIP Code: Board of Agriculture, Division of Water Resources  
Application Number:

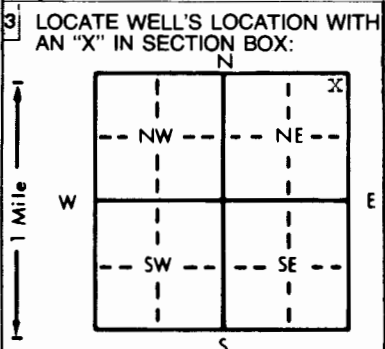

4 DEPTH OF COMPLETED WELL: 120 ft. ELEVATION:  
Depth(s) Groundwater Encountered 1. 80 ft. 2. ft. 3. ft.  
WELL'S STATIC WATER LEVEL 80 ft. below land surface measured on mo/day/yr 8/26/1983  
Pump test data: Well water was MA ft. after hours pumping gpm  
Est. Yield 20 gpm: Well water was ft. after hours pumping gpm  
Bore Hole Diameter 9 in. to 120 ft. and in. to ft.  
WELL WATER TO BE USED AS:  
 Domestic 3 Feedlot 6 Oil field water supply 9 Dewatering 12 Other (Specify below)  
2 Irrigation 4 Industrial 7 Lawn and garden only 10 Observation well  
Was a chemical/bacteriological sample submitted to Department? Yes No ; If yes, mo/day/yr sample was submitted Water Well Disinfected? Yes  No

5 TYPE OF BLANK CASING USED:  
1 Steel 3 RMP (SR) 5 Wrought iron 8 Concrete tile CASING JOINTS: Glued  Clamped  
 PVC 4 ABS 6 Asbestos-Cement 9 Other (specify below) Welded  
7 Fiberglass Threaded  
Blank casing diameter 5 in. to 120 ft., Dia. in. to ft., Dia. in. to ft.  
Casing height above land surface 12 in., weight 3 lbs./ft. Wall thickness or gauge No. 1258

TYPE OF SCREEN OR PERFORATION MATERIAL:  
1 Steel 3 Stainless steel 5 Fiberglass 8 RMP (SR) 10 Asbestos-cement  
2 Brass 4 Galvanized steel 6 Concrete tile 9 ABS 11 Other (specify)  
12 None used (open hole)

SCREEN OR PERFORATION OPENINGS ARE:  
1 Continuous slot 3 Mill slot 5 Gauzed wrapped  8 Saw cut 11 None (open hole)  
2 Louvered shutter 4 Key punched 6 Wire wrapped 9 Drilled holes  
7 Torch cut 10 Other (specify)

SCREEN-PERFORATED INTERVALS: From 120 100 ft. to 120 ft., From ft. to ft.  
From ft. to ft., From ft. to ft.  
GRAVEL PACK INTERVALS: From 14 ft. to 120 ft., From ft. to ft.  
From ft. to ft., From ft. to ft.

6 GROUT MATERIAL:  Neat cement 2 Cement grout 3 Bentonite 4 Other  
Grout Intervals: From 4 ft. to 14 ft., From ft. to ft., From ft. to ft.  
What is the nearest source of possible contamination:  
 Septic tank 4 Lateral lines 7 Pit privy 10 Livestock pens 14 Abandoned water well  
2 Sewer lines 5 Cess pool 8 Sewage lagoon 11 Fuel storage 15 Oil well/Gas well  
3 Watertight sewer lines 6 Seepage pit 9 Feedyard 12 Fertilizer storage 16 Other (specify below)  
13 Insecticide storage  
Direction from well? Northwest How many feet? 300

| FROM | TO  | LITHOLOGIC LOG                   | FROM | TO | LITHOLOGIC LOG |
|------|-----|----------------------------------|------|----|----------------|
| 0    | 3   | topsoil                          |      |    |                |
| 3    | 20  | 9/ red clay                      |      |    |                |
| 20   | 42  | 20 limestone                     |      |    |                |
| 42   | 63  | 2/ blue clay w/ limestone layers |      |    |                |
| 63   | 84  | 2/ red clay                      |      |    |                |
| 84   | 120 | 20 limestone                     |      |    |                |
| 120  |     | stop                             |      |    |                |

7 CONTRACTOR'S OR LANDOWNER'S CERTIFICATION: This water well was (1) constructed, (2) reconstructed, or (3) plugged under my jurisdiction and was completed on (mo/day/year) 8/26/1983 and this record is true to the best of my knowledge and belief. Kansas Water Well Contractor's License No. 359 This Water Well Record was completed on (mo/day/yr) 8/26/1983 under the business name of Daryl Cox & Sons Inc by signature *Daryl Cox*

INSTRUCTIONS: Use typewriter or ball point pen, PLEASE PRESS FIRMLY and PRINT clearly. Please fill in blanks, underline or circle the correct answers. Send top three copies to Kansas Department of Health and Environment, Division of Environment, Environmental Geology Section, Topeka, KS 66620. Send one to WATER WELL OWNER and retain one for your records.