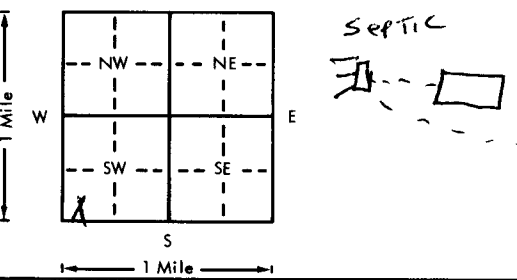


USE TYPEWRITER OR BALL  
POINT PEN-PRESS FIRMLY,  
PRINT CLEARLY.

WATER WELL RECORD  
KSA 82a-1201-1215

Kansas Department of Health and  
Environment-Division of Environment  
(Water well Contractors)  
Topeka, Kansas 66620

1. Location of well:		County <u>GARY</u>	Fraction <u>SW 1/4 SW 1/4 SW 1/4</u>	Section number <u>17</u>	Township number <u>T 10</u>	Range number <u>S R 5</u>	E/W <u>E/W</u>
2. Distance and direction from nearest town or city: <u>5 W E</u>				3. Owner of well: <u>GARY SHANDY</u>			
Street address of well location if in city: <u>OF MILFORD</u>				City, state, zip code: <u>MILFORD</u>			
4. Locate with "X" in section below:		Sketch map:		6. Bore hole dia. <u>8</u> in. Completion date <u>9-14-76</u>			
				Well depth <u>160</u> ft.			
				7. <input checked="" type="checkbox"/> Cable tool <input checked="" type="checkbox"/> Rotary <input type="checkbox"/> Driven <input type="checkbox"/> Dug			
				<input type="checkbox"/> Hollow rod <input type="checkbox"/> Jetted <input type="checkbox"/> Bored <input type="checkbox"/> Reverse rotary			
				8. Use: <input checked="" type="checkbox"/> Domestic <input type="checkbox"/> Public supply <input type="checkbox"/> Industry			
				<input type="checkbox"/> Irrigation <input type="checkbox"/> Air conditioning <input type="checkbox"/> Stock			
				<input type="checkbox"/> Lawn <input type="checkbox"/> Oil field water <input type="checkbox"/> Other			
				9. Casing: Material <u>PVC</u> Height: <u>Above</u> or below			
				Threaded <input type="checkbox"/> Welded <input type="checkbox"/> Surface <u>24</u> in.			
				RMP <input type="checkbox"/> PVC <u>9L</u> Weight <u>258</u> lbs./ft.			
				Dia. <u>5</u> in. to <u>169</u> ft. depth Wall Thickness: inches or			
				Dia. <u>5</u> in. to <u>169</u> ft. depth gauge No. <u>274</u>			
5. Type and color of material		From		To		10. Screen: Manufacturer's name <u>PUMPCO</u>	
<u>TOP SOIL</u>		<u>0</u>		<u>3</u>		Type <u>PVC</u> Dia. <u>5</u>	
<u>grey Lime</u>		<u>3</u>		<u>33</u>		<input checked="" type="checkbox"/> Slot gauge <u>.060</u> Length <u>40</u>	
<u>Shale Red, grey, BIK.</u>		<u>33</u>		<u>87</u>		Set between <u>100</u> ft. and <u>140</u> ft.	
<u>yellow lime</u>		<u>87</u>		<u>93</u>		<u>100</u> ft. and <u>140</u> ft.	
<u>Red shale</u>		<u>93</u>		<u>103</u>		Gravel pack? <input checked="" type="checkbox"/> Size range of material <u>1/4 x 1/8</u>	
<u>Lime, (yellow) - SOFT</u>		<u>103</u>		<u>106</u>		11. Static water level: <u>100</u> ft. below land surface Date <u>9-14-76</u>	
<u>Shale, Red, grey, BIK.</u>		<u>106</u>		<u>141</u>		12. Pumping level below land surfaces:	
<u>Lime, FLINTY, grey, HARD</u>		<u>141</u>		<u>160</u>		<u>9</u> g.p.m.	
						Estimated maximum yield <u>9</u> g.p.m.	
						13. Water sample submitted: <u>Yes</u> <input checked="" type="checkbox"/> No <input type="checkbox"/> Date <u>9-14-76</u>	
						14. Well head completion: <u>CAP</u>	
						<u>Pitless adapter</u> <u>24</u> inches above grade	
						15. Well grouted? <input checked="" type="checkbox"/>	
						With: <input checked="" type="checkbox"/> Neat cement <input type="checkbox"/> Bentonite <input type="checkbox"/> Concrete	
						Depth: From <u>5</u> ft. to <u>15</u> ft.	
						16. Nearest source of possible contamination: <u>W</u> Type <u>SEPTIC</u>	
						ft. <u>200</u> Direction <u>W</u> Type <u>SEPTIC</u>	
						Well disinfected upon completion? <input checked="" type="checkbox"/> Yes <input type="checkbox"/> No	
						17. Pump: <input checked="" type="checkbox"/> Not installed	
						Manufacturer's name _____	
						Model number _____ HP _____ Volts _____	
						Length of drop pipe _____ ft. capacity _____ g.p.m.	
						Type:	
						<input type="checkbox"/> Submersible <input type="checkbox"/> Turbine	
						<input type="checkbox"/> Jet <input type="checkbox"/> Reciprocating	
						<input type="checkbox"/> Centrifugal <input type="checkbox"/> Other	
18. Elevation:		19. Remarks:		20. Water well contractor's certification:			
Topography: <u>Hill</u>		<u>owner will install slab</u>		This well was drilled under my jurisdiction and this report is true to the best of my knowledge and belief.			
<u>Slope</u>				<u>Strader Delg Co Inc</u> <u>182</u>			
<u>Upland</u>				Business name _____ License No. _____			
<u>Valley</u>				Address <u>RT1 Heaton, KS</u>			
				Signed <u>Dale Raden</u> Date <u>9-20-76</u>			
				Authorized representative			