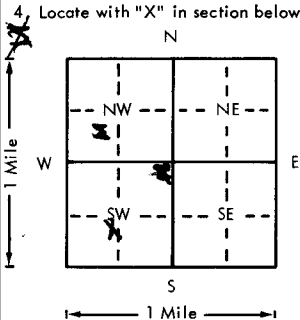


USE TYPEWRITER OR BALL
POINT PEN-PRESS FIRMLY,
PRINT CLEARLY.

WATER WELL RECORD
KSA 82a-1201-1215

Kansas Department of Health and
Environment-Division of Environment
(Water well Contractors)
Topeka, Kansas 66620

1. Location of well:		County Geary	Fraction ne 1/4 SW 1/4 SW 1/4	Section number 29	Township number T 10 S R 5	Range number 5
2. Distance and direction from nearest town or city: 1 mile south Street address of well location if in city: Milford			3. Owner of well: DEPARTMENT OF THE ARMY R.R. or street: Corps of Engineers RR 3 Box 303 City, state, zip code: Junction City, Ks. 66441			
4. Locate with "X" in section below:		Sketch map:		6. Bore hole dia. 8" in. Completion date 3/22/78 Well depth 150 ft.		
				7. <input type="checkbox"/> Cable tool <input checked="" type="checkbox"/> Rotary <input type="checkbox"/> Driven <input type="checkbox"/> Dug <input type="checkbox"/> Hollow rod <input type="checkbox"/> Jetted <input type="checkbox"/> Bored <input type="checkbox"/> Reverse rotary		
				8. Use: <input type="checkbox"/> Domestic <input checked="" type="checkbox"/> Public supply <input type="checkbox"/> Industry <input type="checkbox"/> Irrigation <input type="checkbox"/> Air conditioning <input type="checkbox"/> Stock <input type="checkbox"/> Lawn <input type="checkbox"/> Oil field water <input type="checkbox"/> Other		
5. Type and color of material		From	To	9. Casing: Material PVC Height: Above or below Threaded <input type="checkbox"/> Welded <input checked="" type="checkbox"/> Surface 12 in. RMP <input type="checkbox"/> PVC <input checked="" type="checkbox"/> Weight 3 lbs./ft. Dia. 5 in. to 150 ft. depth Wall Thickness: inches or Dia. <input type="checkbox"/> in. to <input type="checkbox"/> ft. depth gage No. 258		
Limestone Fill		0	4	10. Screen: Manufacturer's name Pumpco Type PVC Dia. 5" Slot/gauze 1/16" Length 30' Set between 40 ft. and 60 ft. 140 ft. and 150 ft. Gravel pack? Yes Size range of material 1/8-3/4"		
Topsoil		4	7	11. Static water level: 42 ft. below land surface Date 3/22/78 mo./day/yr.		
Brown Clay		7	18	12. Pumping level below land surfaces: ____ ft. after ____ hrs. pumping ____ g.p.m. ____ ft. after NA hrs. pumping ____ g.p.m. Estimated maximum yield 3 g.p.m.		
Blue Clay		18	27	13. Water sample submitted: ____ mo./day/yr. Yes <input type="checkbox"/> No <input checked="" type="checkbox"/> Date ____		
Limestone		27	33	14. Well head completion: ____ Pitless adapter 12 inches above grade		
Blue Clay		33	43	15. Well grouted? Yes With: <input checked="" type="checkbox"/> Neat cement <input type="checkbox"/> Bentonite <input type="checkbox"/> Concrete Depth: From 0 ft. to 20 ft.		
Limestone		43	62	16. Nearest source of possible contamination: ft. 250' Direction West Type Lake Well disinfected upon completion? <input checked="" type="checkbox"/> Yes <input type="checkbox"/> No		
Blue Clay		62	111	17. Pump: <input checked="" type="checkbox"/> Not installed Manufacturer's name ____ Model number ____ HP ____ Volts ____ Length of drop pipe ____ ft. capacity ____ g.p.m. Type: <input type="checkbox"/> Submersible <input type="checkbox"/> Turbine <input type="checkbox"/> Jet <input type="checkbox"/> Reciprocating <input type="checkbox"/> Centrifugal <input type="checkbox"/> Other		
Red Clay		111	118			
Blue Clay		118	153			
Red Clay		153	156			
Blue Clay		156	180			
Stop		180				
(Use a second sheet if needed)						
18. Elevation:	19. Remarks:			20. Water well contractor's certification: This well was drilled under my jurisdiction and this report is true to the best of my knowledge and belief. Daryl Cox & Sons Inc. 359 Business name License No. Address Clifton, Kansas 66937 Signed Daryl Cox Date 3/27/78 Authorized representative		
Topography: <input type="checkbox"/> Hill <input type="checkbox"/> Slope <input checked="" type="checkbox"/> Upland <input type="checkbox"/> Valley						

Forward the white, blue and pink copies to the Department of Health and Environment

Form WWC-5