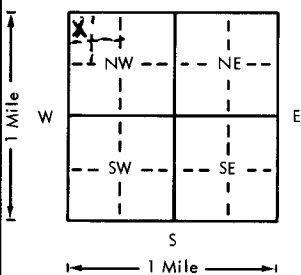


USE TYPEWRITER OR BALL
POINT PEN-PRESS FIRMLY,
PRINT CLEARLY.

WATER WELL RECORD
KSA 82a-1201-1215

Kansas Department of Health and
Environment-Division of Environment
(Water well Contractors)
Topeka, Kansas 66620

1. Location of well:	County Geary	Fraction NW 1/4 NW 1/4 NW 1/4	Section number 32	Township number T 10 S	Range number R 5 E
2. Distance and direction from nearest town or city: 3 miles southeast Street address of well location if in city: of Milford			3. Owner of well: Orville McDonald R.R. or street: Lot 20 Cedar Estates Sub. Div. City, state, zip code: Milford, Kansas		
4. Locate with "X" in section below: 			Sketch map:		
5. Type and color of material			From	To	6. Bore hole dia. 8 in. Completion date 12/8/76 Well depth 143 ft.
Sand and clay			0	54	7. <input checked="" type="checkbox"/> Cable tool <input checked="" type="checkbox"/> Rotary <input type="checkbox"/> Driven <input type="checkbox"/> Dug <input type="checkbox"/> Hollow rod <input type="checkbox"/> Jetted <input type="checkbox"/> Bored <input type="checkbox"/> Reverse rotary
Total loss of circulation			54		8. Use: <input checked="" type="checkbox"/> Domestic <input type="checkbox"/> Public supply <input type="checkbox"/> Industry <input type="checkbox"/> Irrigation <input type="checkbox"/> Air conditioning <input type="checkbox"/> Stock <input type="checkbox"/> Lawn <input type="checkbox"/> Oil field water <input type="checkbox"/> Other
Rock and shale			54	143	9. Casing: Material plst Height: Above or below Threaded <input type="checkbox"/> Welded <input checked="" type="checkbox"/> Surface 18 in. RMP <input checked="" type="checkbox"/> PVC <input type="checkbox"/> Weight <input type="checkbox"/> lbs./ft. Dia. 5 in. to 143 ft. depth Wall Thickness: inches or Dia. <input type="checkbox"/> in. to <input type="checkbox"/> ft. depth gage No. 0.258
					10. Screen: Manufacturer's name Western Plastics Type RMP Dia. 5 1/2 Slot/gauze 3/32 Length 43 Set between 100 ft. and 143 ft. ft. and ft. Gravel pack? Yes Size range of material 1/16 to 3/8
					11. Static water level: 94 ft. below land surface Date 12/8/76
					12. Pumping level below land surfaces: ft. after hrs. pumping g.p.m. ft. after hrs. pumping g.p.m. Estimated maximum yield 10 g.p.m.
					13. Water sample submitted: Yes <input checked="" type="checkbox"/> No <input type="checkbox"/> Date
					14. Well head completion: <input checked="" type="checkbox"/> Pitless adapter <input type="checkbox"/> Inches above grade
					15. Well grouted? Yes With: <input checked="" type="checkbox"/> Neat cement <input type="checkbox"/> Bentonite <input type="checkbox"/> Concrete Depth: From 0 ft. to 10 ft.
					16. Nearest source of possible contamination: septic tank ft. 300 Direction West Type tank Well disinfected upon completion? <input checked="" type="checkbox"/> Yes <input type="checkbox"/> No
					17. Pump: <input type="checkbox"/> Not installed Manufacturer's name Dempster Model number 3/4 HP 3/4 Volts Length of drop pipe 130 ft. capacity g.p.m. Type: <input checked="" type="checkbox"/> Submersible <input type="checkbox"/> Turbine <input type="checkbox"/> Jet <input type="checkbox"/> Reciprocating <input type="checkbox"/> Centrifugal <input type="checkbox"/> Other
					20. Water well contractor's certification: This well was drilled under my jurisdiction and this report is true to the best of my knowledge and belief. Rader Drilling Co. 194 Business name Carlton, Kansas License No. Address Brent & Rader Signed Brent & Rader Date 3-11-77 Authorized representative
18. Elevation:	19. Remarks:				
Topography: <input checked="" type="checkbox"/> Hill <input type="checkbox"/> Slope <input type="checkbox"/> Upland <input type="checkbox"/> Valley					

Forward the white, blue and pink copies to the Department of Health and Environment

Form WWC-5